

NATURAL RESOURCES
COMMISSION

JERRY C. BARTNIK
LARRY DEVUYST
PAUL EISELE
JAMES P. HILL
DAVID HOLLI
JOEY M. SPANO
JORDAN B. TATTER

STATE OF MICHIGAN



JOHN ENGLER, Governor

DEPARTMENT OF NATURAL RESOURCES

Stevens T. Mason Building, P.O. Box 30028, Lansing, MI 48909

ROLAND HARMES, Director

AH. #1

H1

August 10, 1993

US EPA RECORDS CENTER REGION 5



471866

Mr. Rauland Sharp (HSRW-6J)
Remedial Project Manager
U.S. EPA, Region 5
77 West Jackson Blvd.
Chicago, IL 60604

Dear Mr. Sharp:

Subject: Michigan Department of Natural Resources Recommendations for
Additional Remedial Investigation Field Work at the Albion-Sheridan
Township Landfill Superfund Site, Calhoun County, Michigan.

During our teleconference on Thursday August 5, 1993, the Michigan Department of Natural Resources (MDNR) agreed to supply the U.S. Environmental Protection Agency (EPA) with our recommendations for additional field work that we deemed necessary to further define the contaminant plume emanating from the landfill. The MDNR expressed its concerns that there could be a serious threat to the quality of the Marshall Sandstone bedrock aquifer which serves as a regional water supply for private and public water supplies.

Listed below are our recommendations for some additional field work that is necessary for us to be able to evaluate the nature, extent and fate of the contaminants identified by the work the EPA has recently completed.

Recommendations

1. A map should be provided that shows other major (municipal, industrial, agricultural) pumping wells near the site and between the site and city. Information should be provided on their pumping rates.

Additionally, a regional map of static water levels in the bedrock aquifer should be made. This will help us understand the possible interactions of the site with this aquifer. Also the potential effects of the major wells on the aquifer under the site can better be evaluated.

2. Larger cross sections using other well logs in the area should be made to help define the geology of the site.

3. A bed rock topography map, a weathered bedrock topography map, an aquifer thickness map of the glacial aquifer and a weathered bedrock aquifer thickness map would provide for easier analysis of the aquifer and contaminate transport.
4. Has a calculation been made of how much water the river gains in the vicinity of the landfill? If not, this might be helpful information to determine how much water is discharging from the aquifer to the river. If there is sufficient data, various reaches of the river could be analyzed to determine discharge points from the aquifer.
5. One of the difficulties with the data that we have is that, it is difficult to determine where groundwater is coming from and how the different "aquifers" (glacial, weathered bedrock, bedrock) are interacting. Also, the interpretation of how the contamination is getting into the lower aquifer is not clearly defined. It would be helpful to prepare Stiff/Piper diagrams and to do geochemical analysis of the aquifers. This would mean sampling for carbonate, bicarbonate, sodium, calcium, magnesium, iron, sulfate and chloride during another round of sampling. Ion-cation balances should also be done.
6. We recommend that total dissolved solids maps and cross sections be drawn.
7. We recommend that the location of the abandoned septic field be placed upon a map.

Well Locations and Justification

The following comments relate to the map of proposed well nest locations that I have attached to this memo. Generally these locations have been chosen in order to address specific concerns. However, overall we believe that a more complete picture of the site geology, site hydrogeology and contaminate distribution is needed. The present data is insufficient to provide a more complete picture of the site.

Each of these wells should be vertically sampled for VOCs and field parameters. As a minimum, we recommend a nest of three wells at each location; one for each of the distinct hydrogeologic environments. Also, only four (4) well nests are recommended at this time. However, should contamination be found in any of the wells, the need for additional wells will need to be evaluated.

Although we are not making any specific recommendations at this time, we would like to discuss the utility of trying to determine the relationship of the landfill contamination and its connection to the groundwater contamination. (i.e. is there a particular area that is contributing the majority of the contaminants to the aquifer?)

Well Nest #1

Well nest #1 is located between the river and the plume to help determine to what extent the bedrock aquifer is discharging to the river.

Well nest #2 is located downgradient of MW9 in order to determine the end of the plume in this direction and to provide more information on the vinyl chloride contamination.

Well nest #3 is located approximately downgradient of MW* in order to determine the extent of the plume in this direction, to provide more information on the vinyl chloride contamination in this direction and to provide more hydrogeologic information on the mounded or perched aquifer in this area. Additionally, it will help better define the hydrogeologic characteristics of the weathered bedrock and bedrock aquifers in this area. We are uncertain of how far the influence of the major pumping wells extends toward the site.

Well nest #4 is located on the other side of, or near the center of, a potential groundwater divide. We feel it is important to insure that no undetected contamination is moving toward the Orchard No11 area. Additionally, a nest of wells in this area would provide data that would help fill a major gap in our understanding on the groundwater flow away from the site.

As stated previously, these are somewhat tentative recommendations. The site hydrogeology is complicated by a variety of factors and to date the chemical data is contradictory. We feel it would be very beneficial to meet with EPA and WW to discuss further actions at the site in regards to the groundwater investigation and are willing to do so at your earliest convenience.



If you have any questions and/or you would like to set up a meeting, feel free to contact me.

Sincerely,



Gene L. Hall
Superfund Section
Environmental Response Division
517-373-6808

cc: Ms. Claudia Kerbawy, MDNR
Mr. James Heinzman, MDNR
Mr. Robert Delaney, MDNR
Albion-Sheridan Township file (H-1)

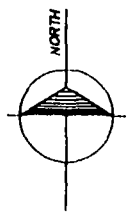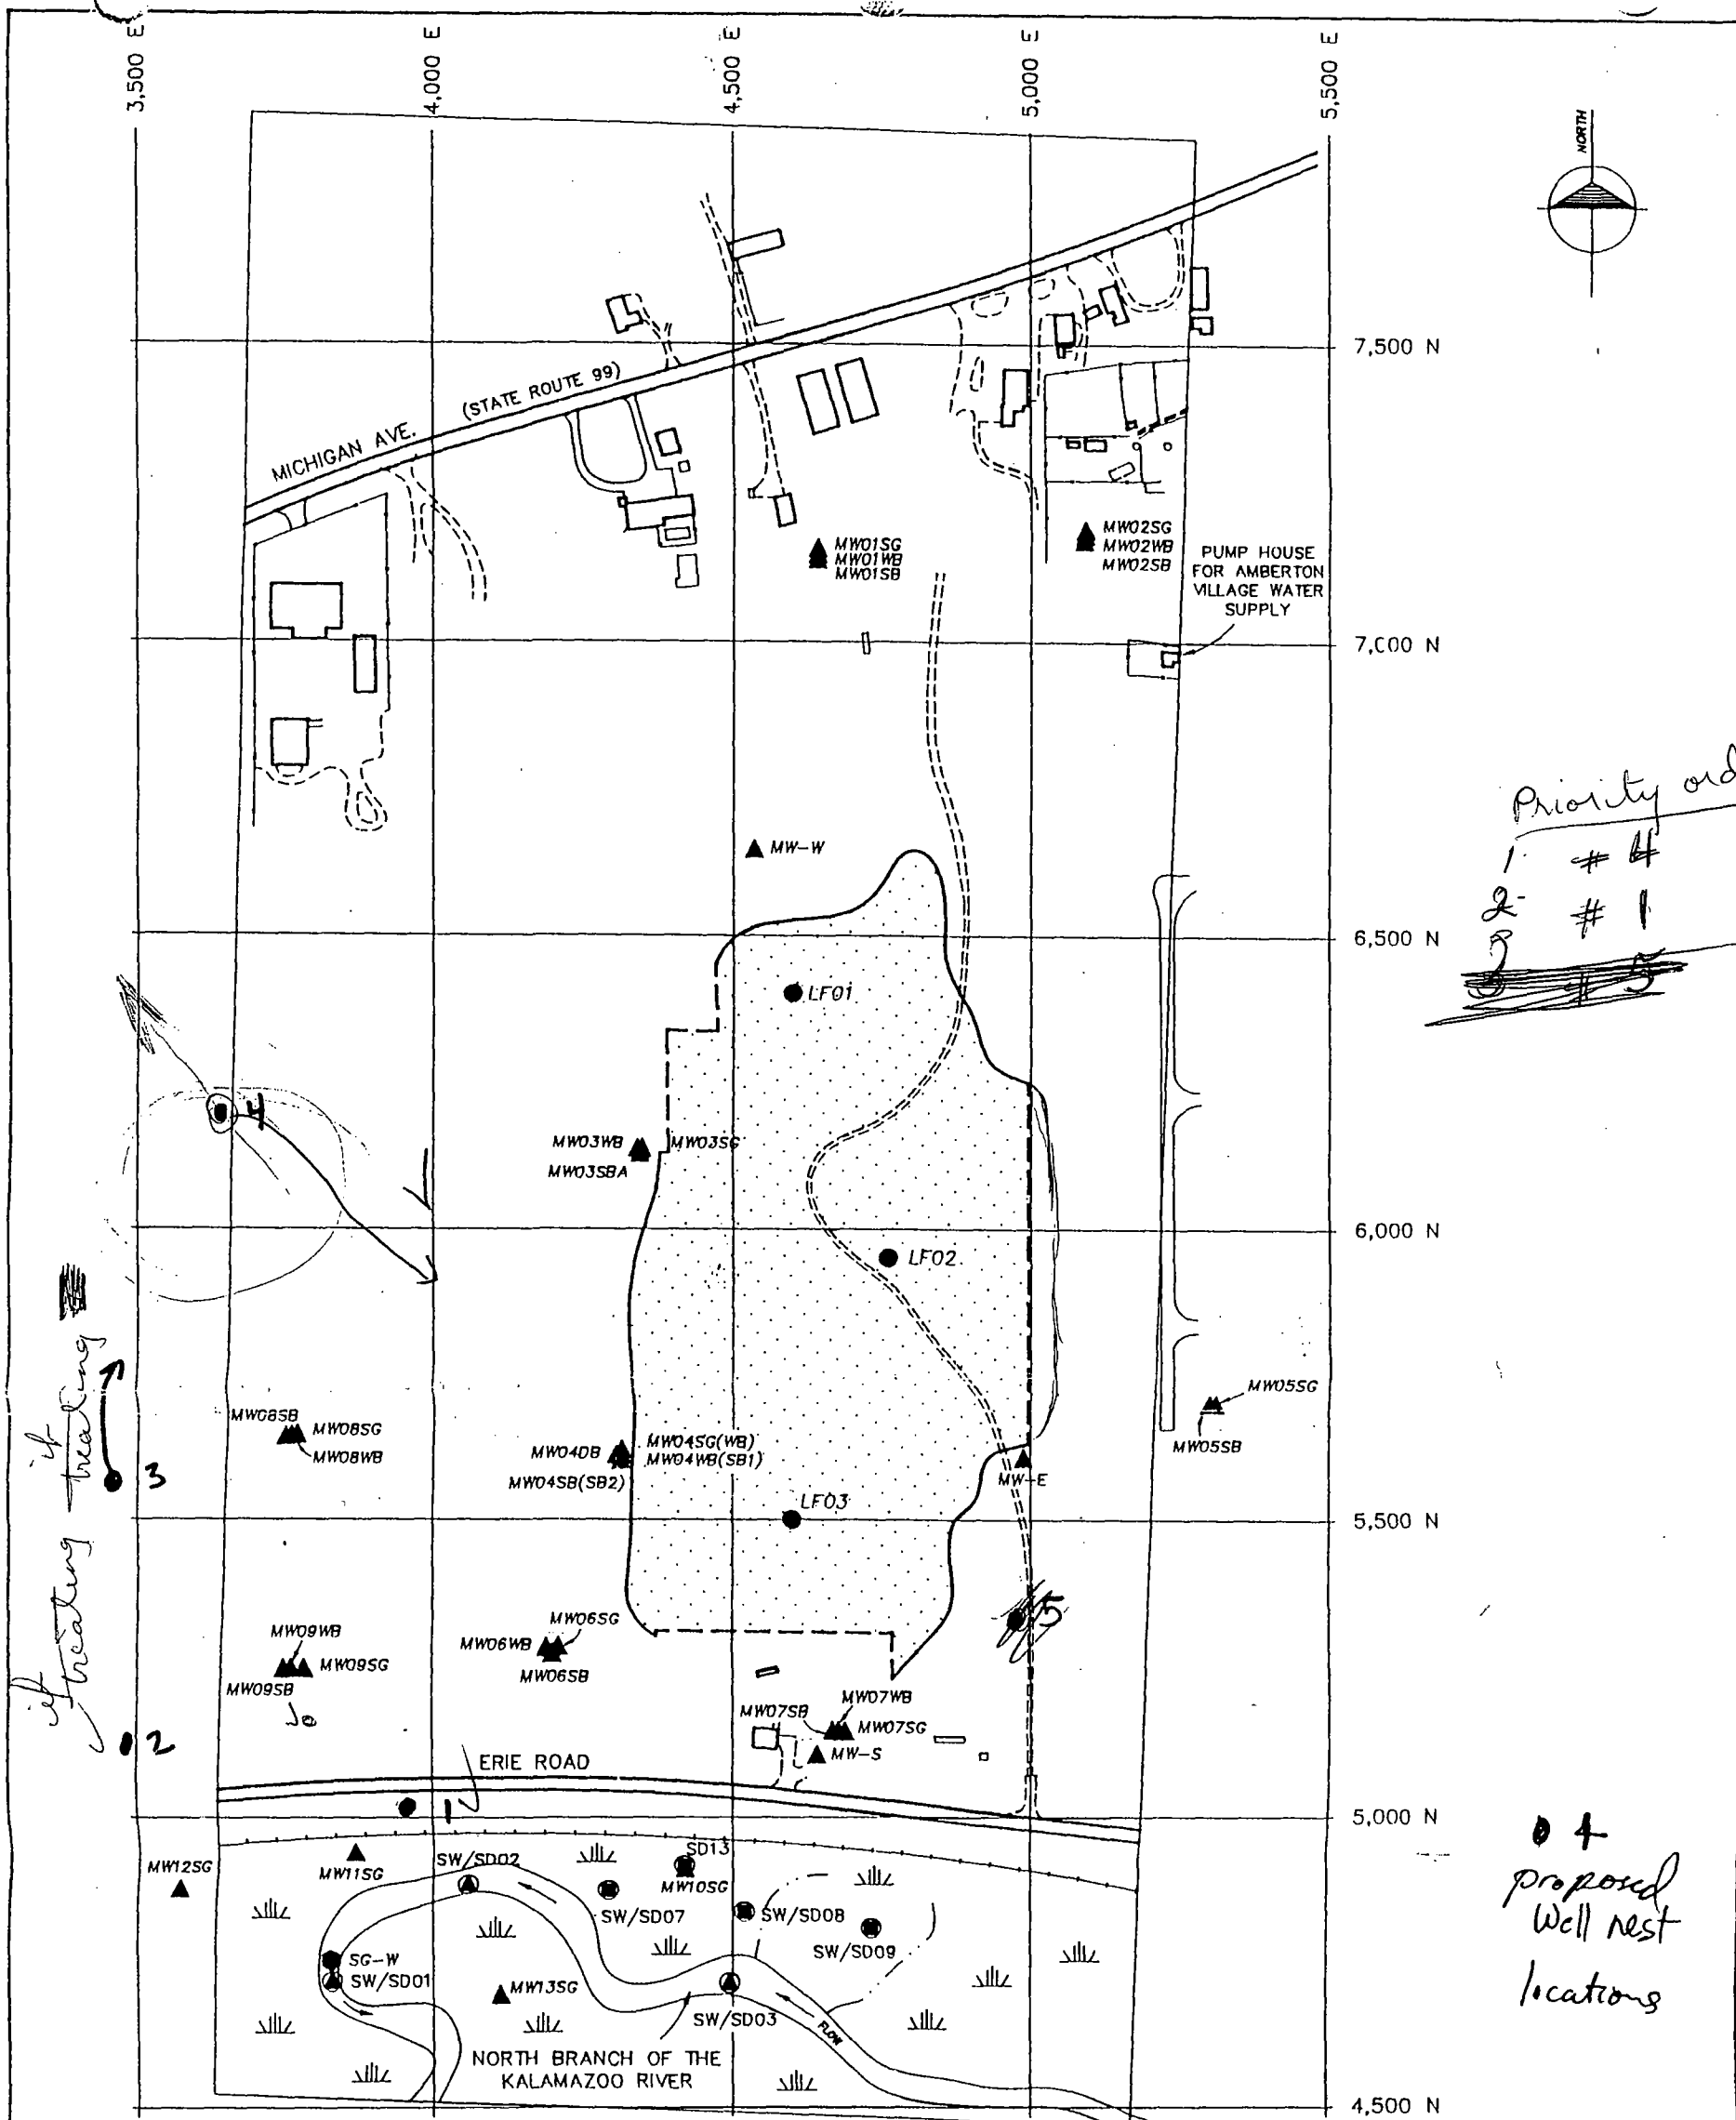



Priority order

1	# 4
2	# 1
3	# 5

*0 4
proposed
Well nest
locations*

LEGEND

- APPROXIMATE LANDFILL BOUNDARY (DASHED PORTIONS INDICATE THE SURVEY GRID BOUNDARY)
- UNPAVED ROAD
- INTERMITTENT STREAM
- RAILROAD TRACK
- MONITORING WELL LOCATION
- LEACHATE WELL LOCATION
- STAFF GAUGE LOCATION
- LOCATION OF WETLAND WATER/ SEDIMENT SAMPLING SITES
- LOCATION OF RIVER WATER/ SEDIMENT SAMPLING TRANSECTS
- APPROXIMATE WETLAND AREA

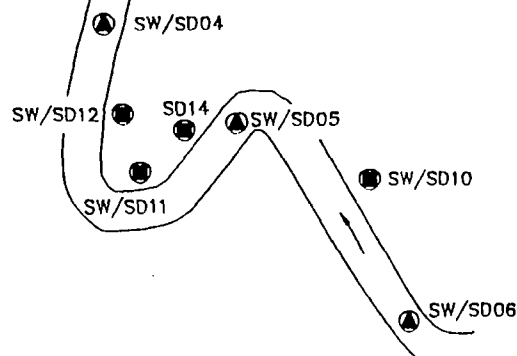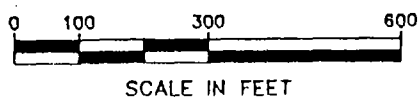

04011-SW
LVP052193


FIGURE 9

SURFACE WATER/SEDIMENT SAMPLE LOCATION MAP

ALBION-SHERIDAN TOWNSHIP LANDFILL
ALBION, MICHIGAN

MAY, 1993

04011.03

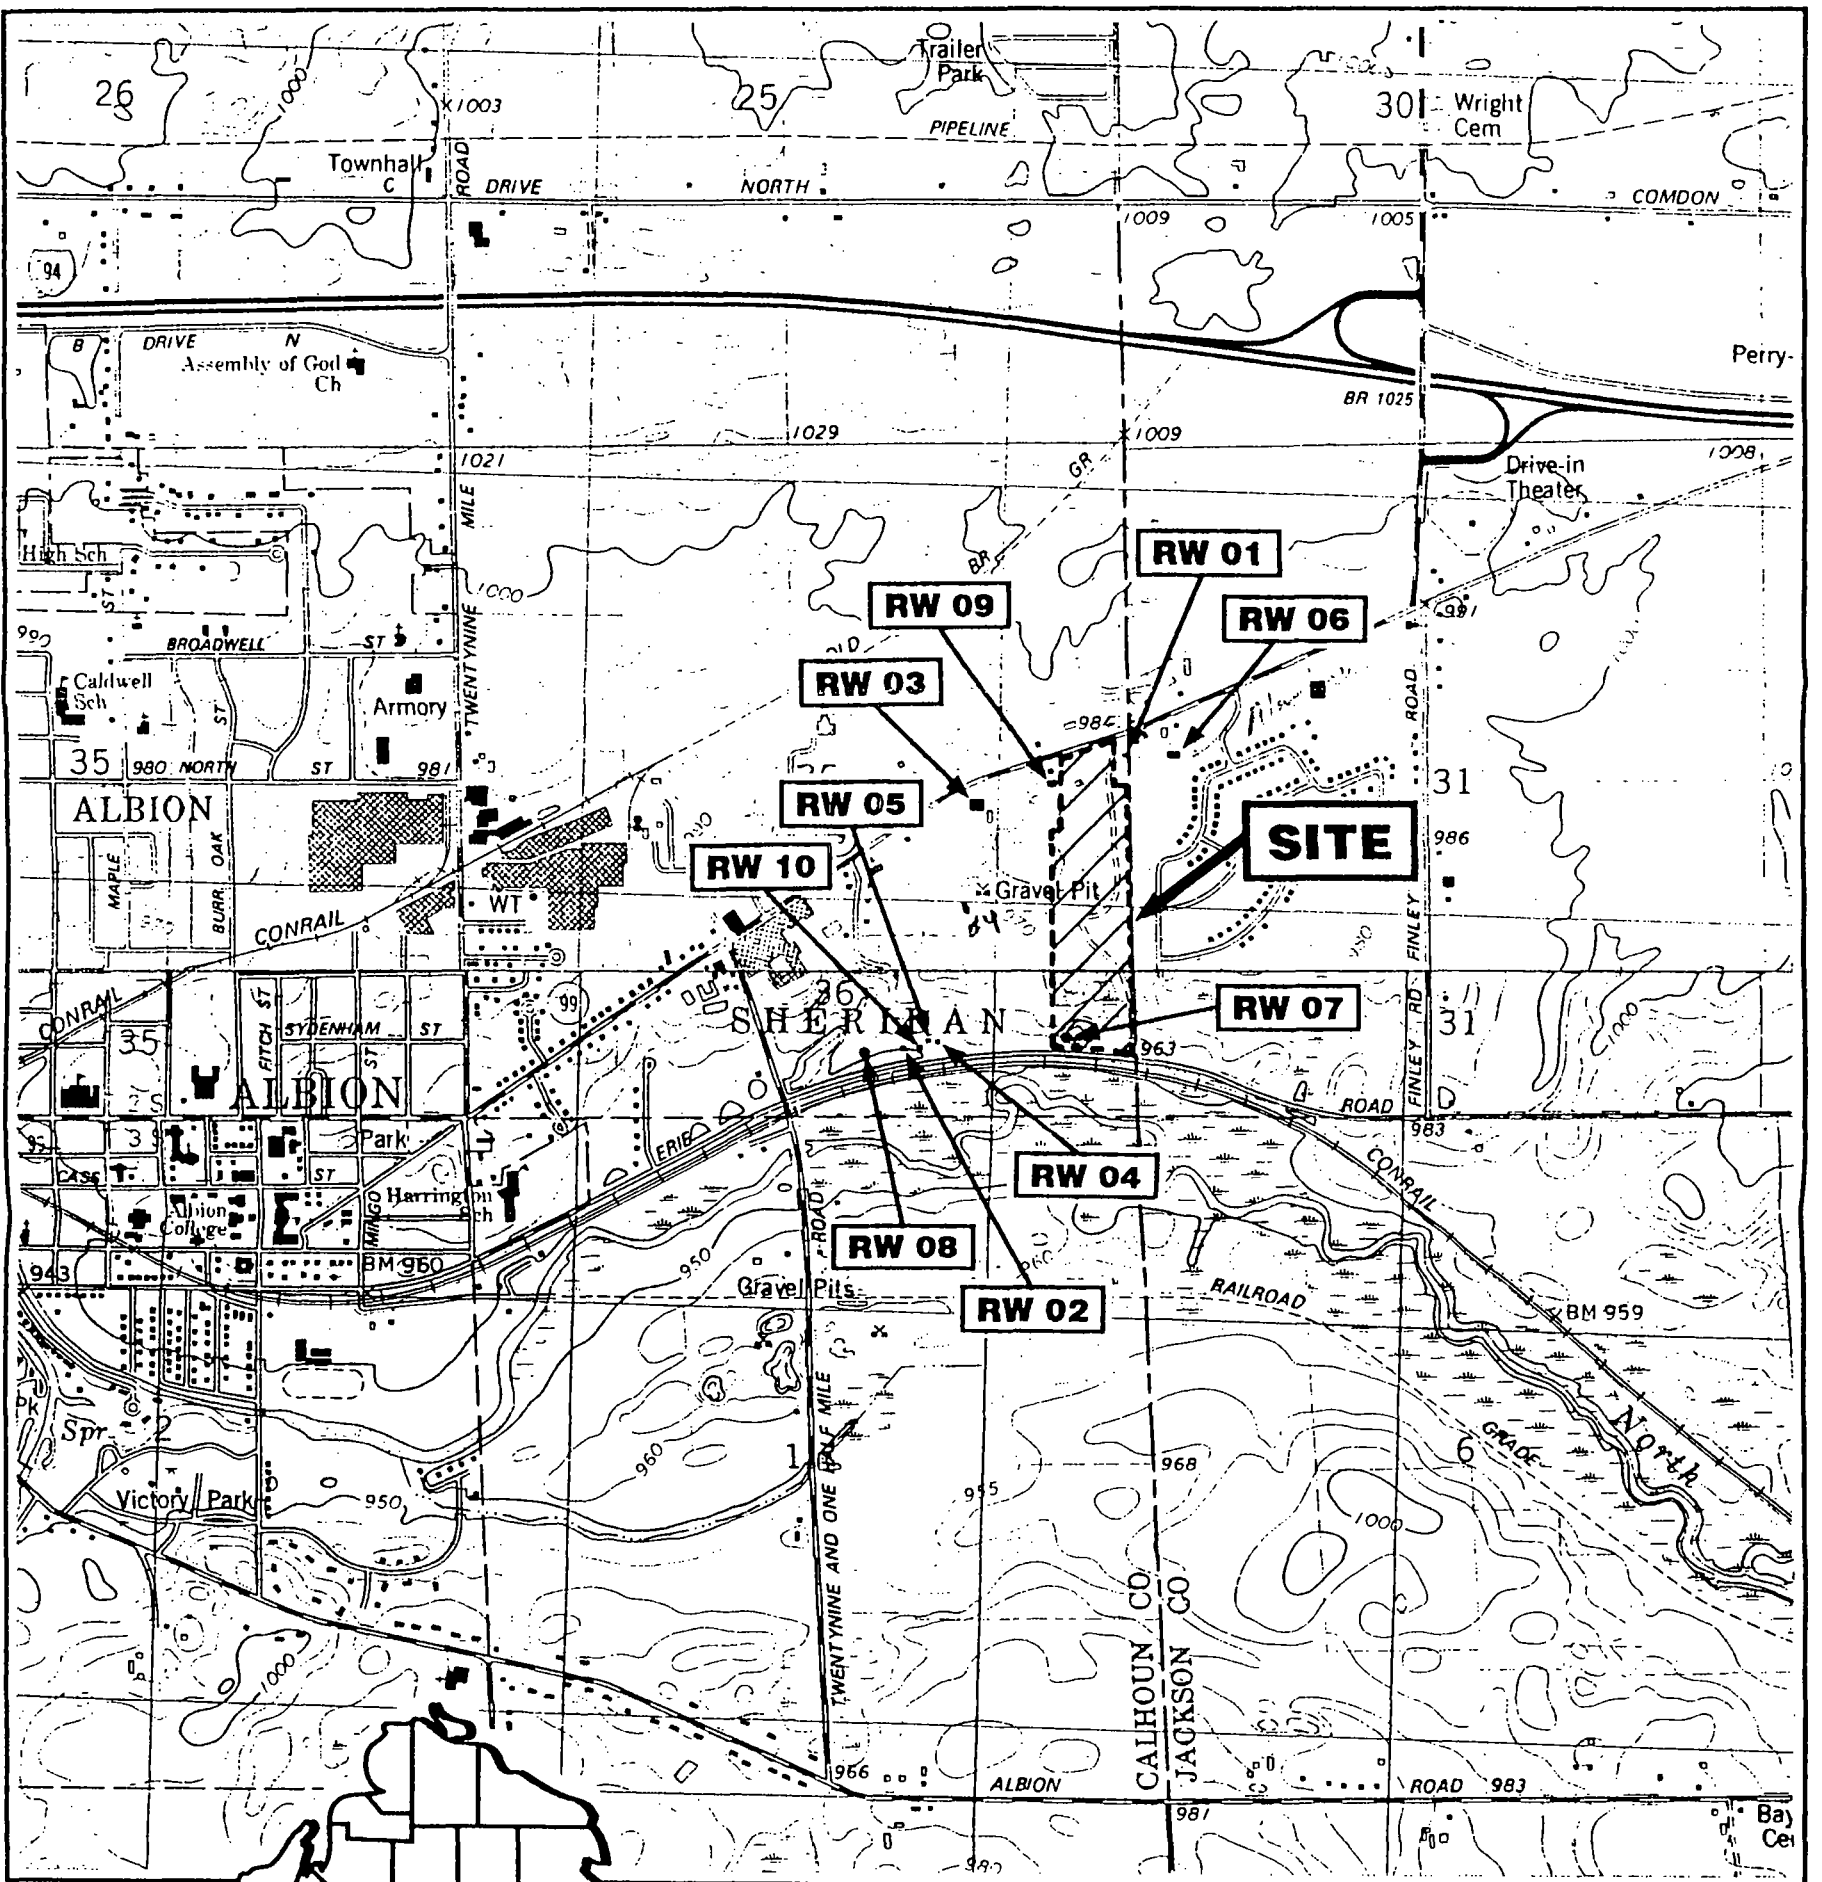

Southeast and Northeast Albion Quadrangles U.S.G.S. 7.5 minute series, 1981



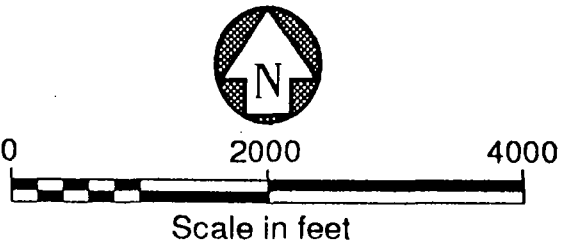


FIGURE 10





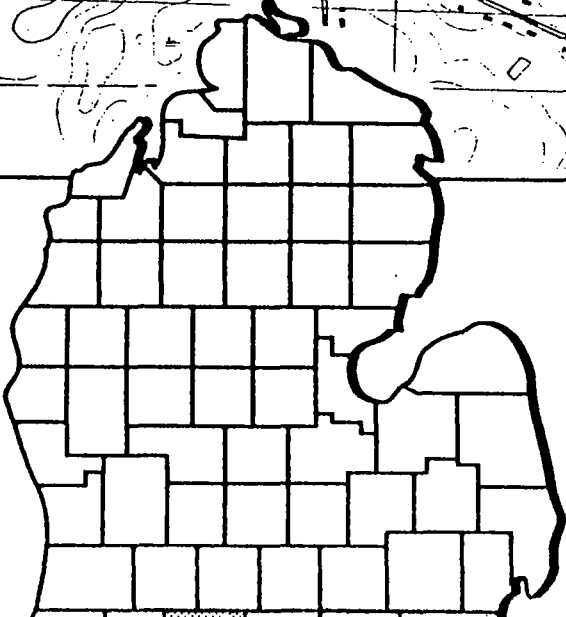

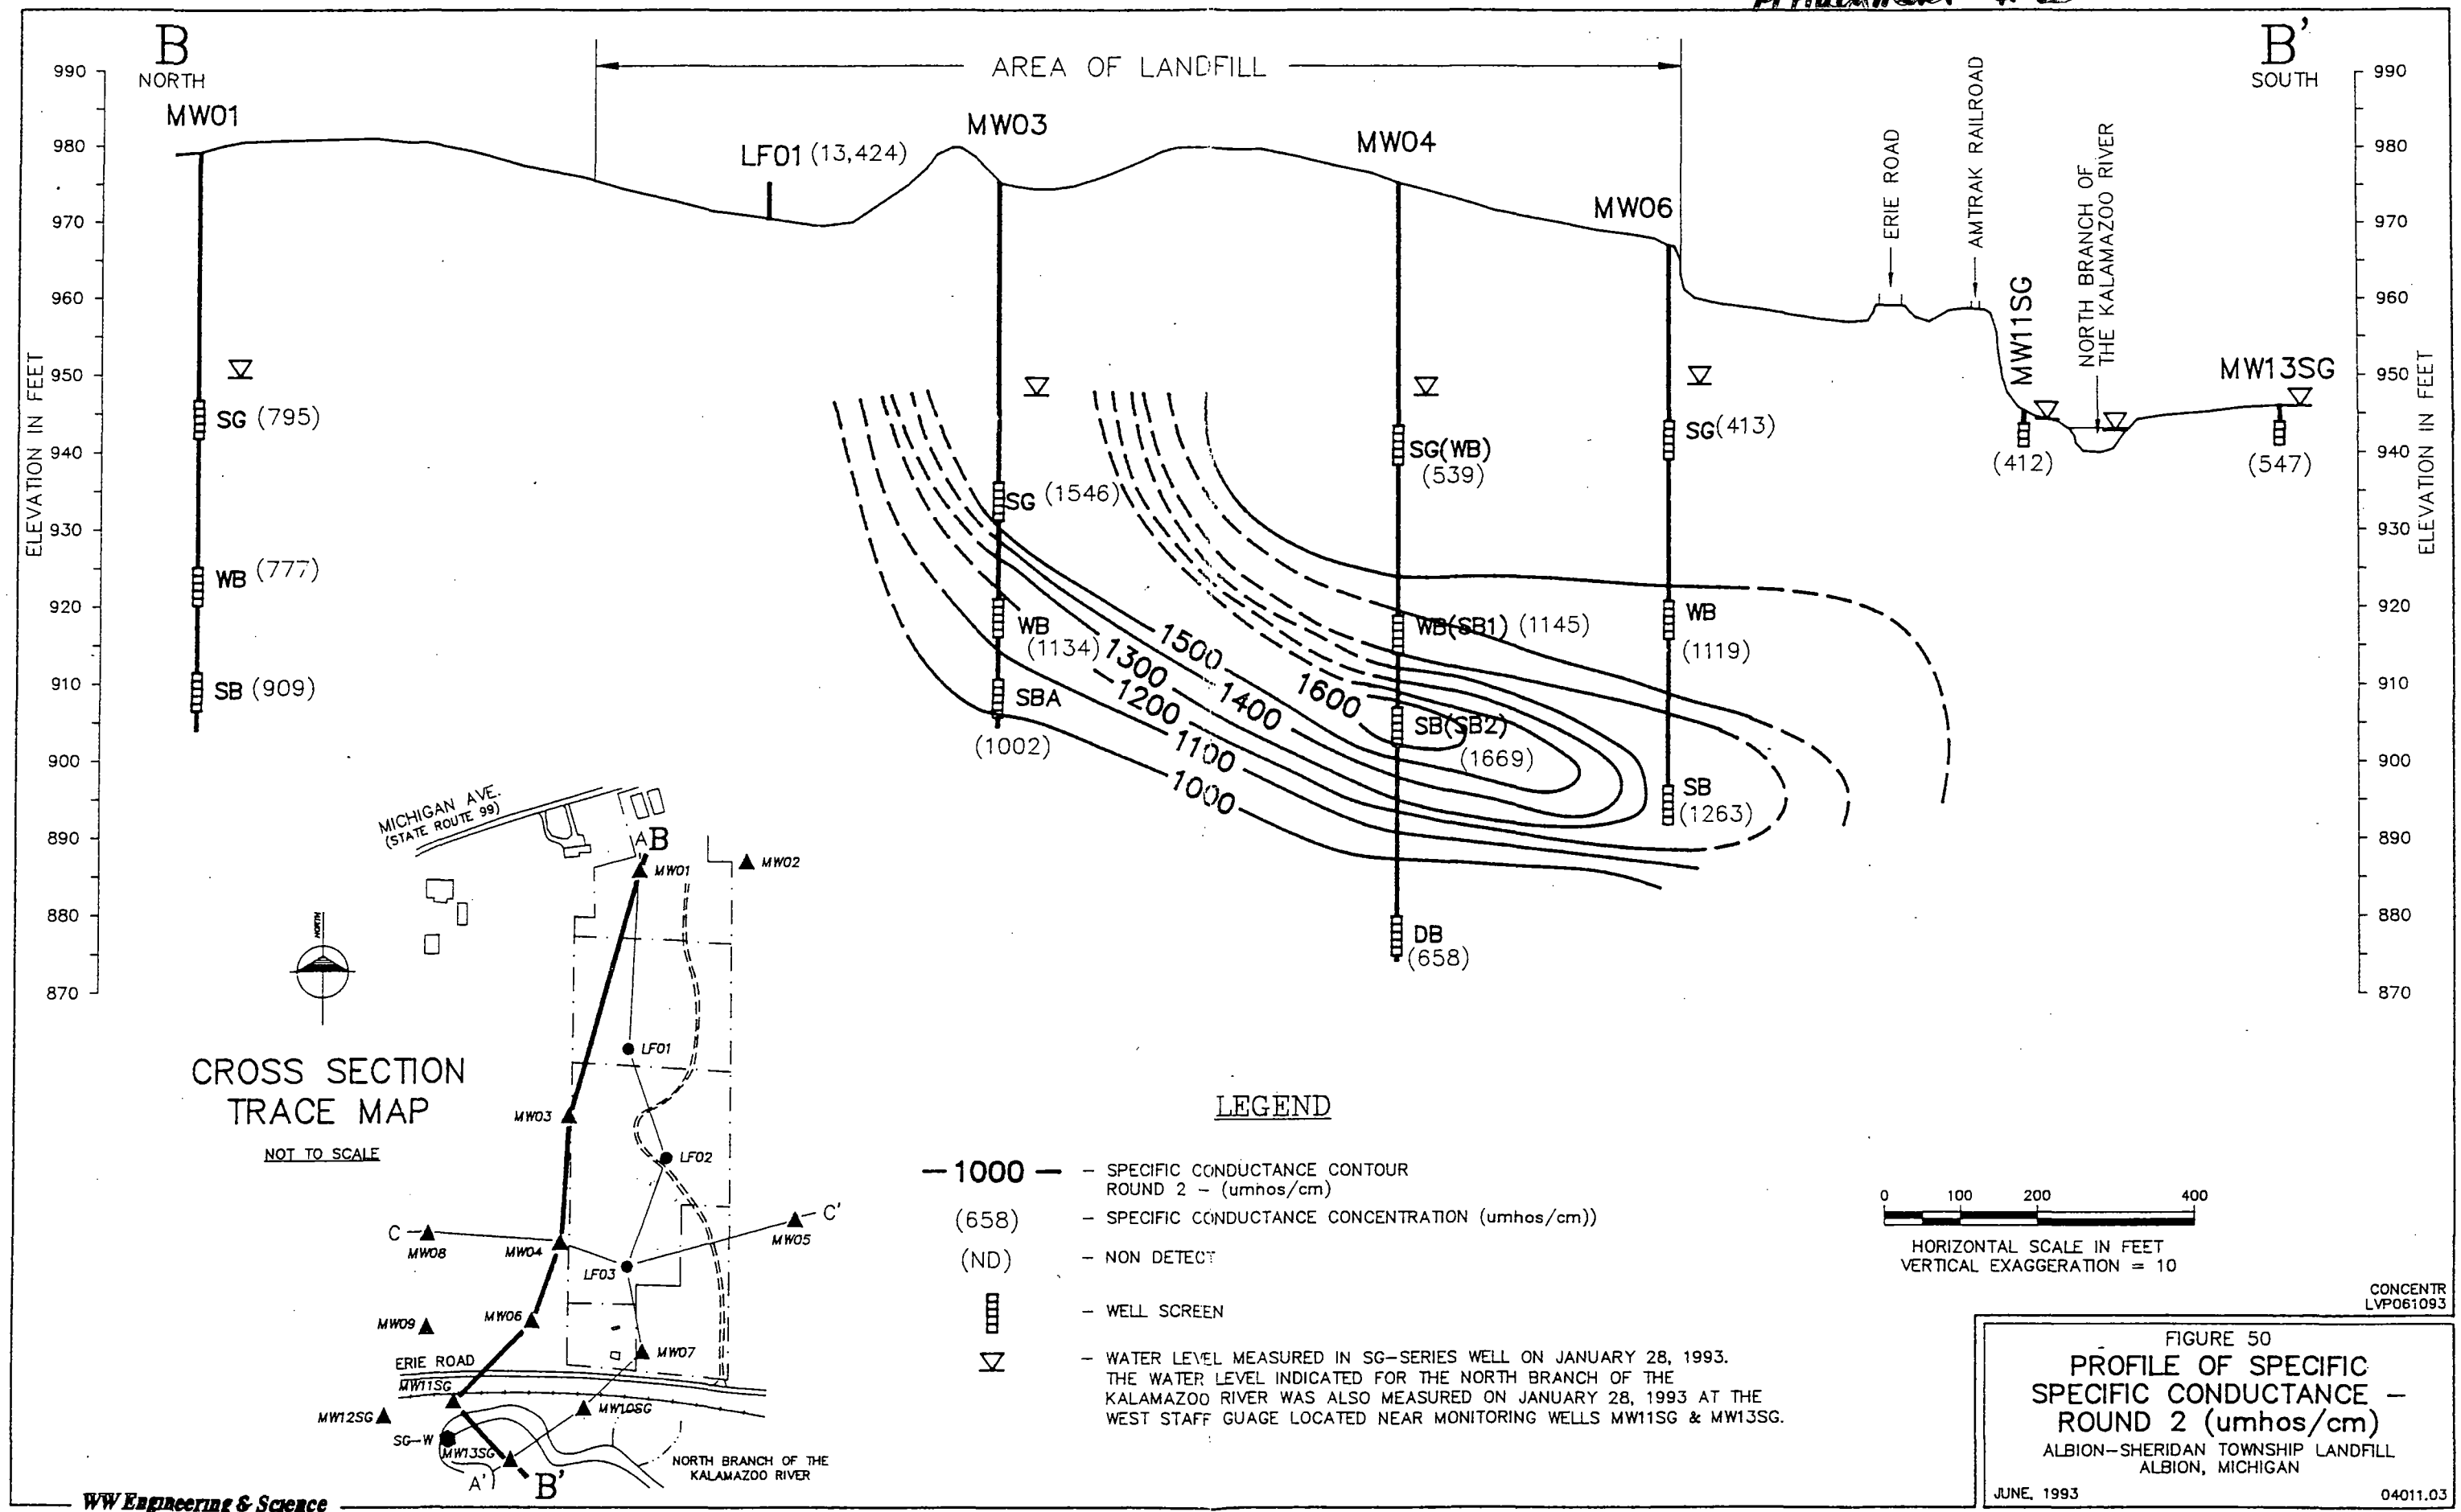




 
 



Dec. 22. 1992
glacial
Statics

Elevation
of GW at
MW 8 is
956
Ground surface
elevation at
MW 9 is 956

947.07

Static Water
level at ~~W~~Woy
in the well screened
just below the
water table.

-  - APPROXIMATE LANDFILL BOUNDARY (DASHED PORTIONS INDICATE THE SURVEY GRID BOUNDARY)
-  - PROPERTY BOUNDARY
-  - TOPOGRAPHIC CONTOUR (10ft. interval)
-  - UNPAVED ROAD
-  - INTERMITTENT STREAM
-  - RAILROAD TRACK
-  - MONITORING WELL LOCATION
-  - LEACHATE WELL LOCATION
-  - STAFF GAUGE LOCATION
-  - LIMITS OF AREA SURVEYED WITH EM-34
-  - CONTOURED FM34 CONDUCTIVITY
-  - DEEP EM VALUES EXCEEDING 6 mmhos/m



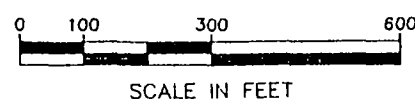


FIGURE 14A
CONTOUR MAP OF
EM34 QUADRATURE PHASE
CONDUCTIVITY DATA
(20M HORIZONTAL)


ALBION-SHERIDAN TOWNSHIP LANDFILL
JUNE, 1993 ALBION, MICHIGAN 04011.03

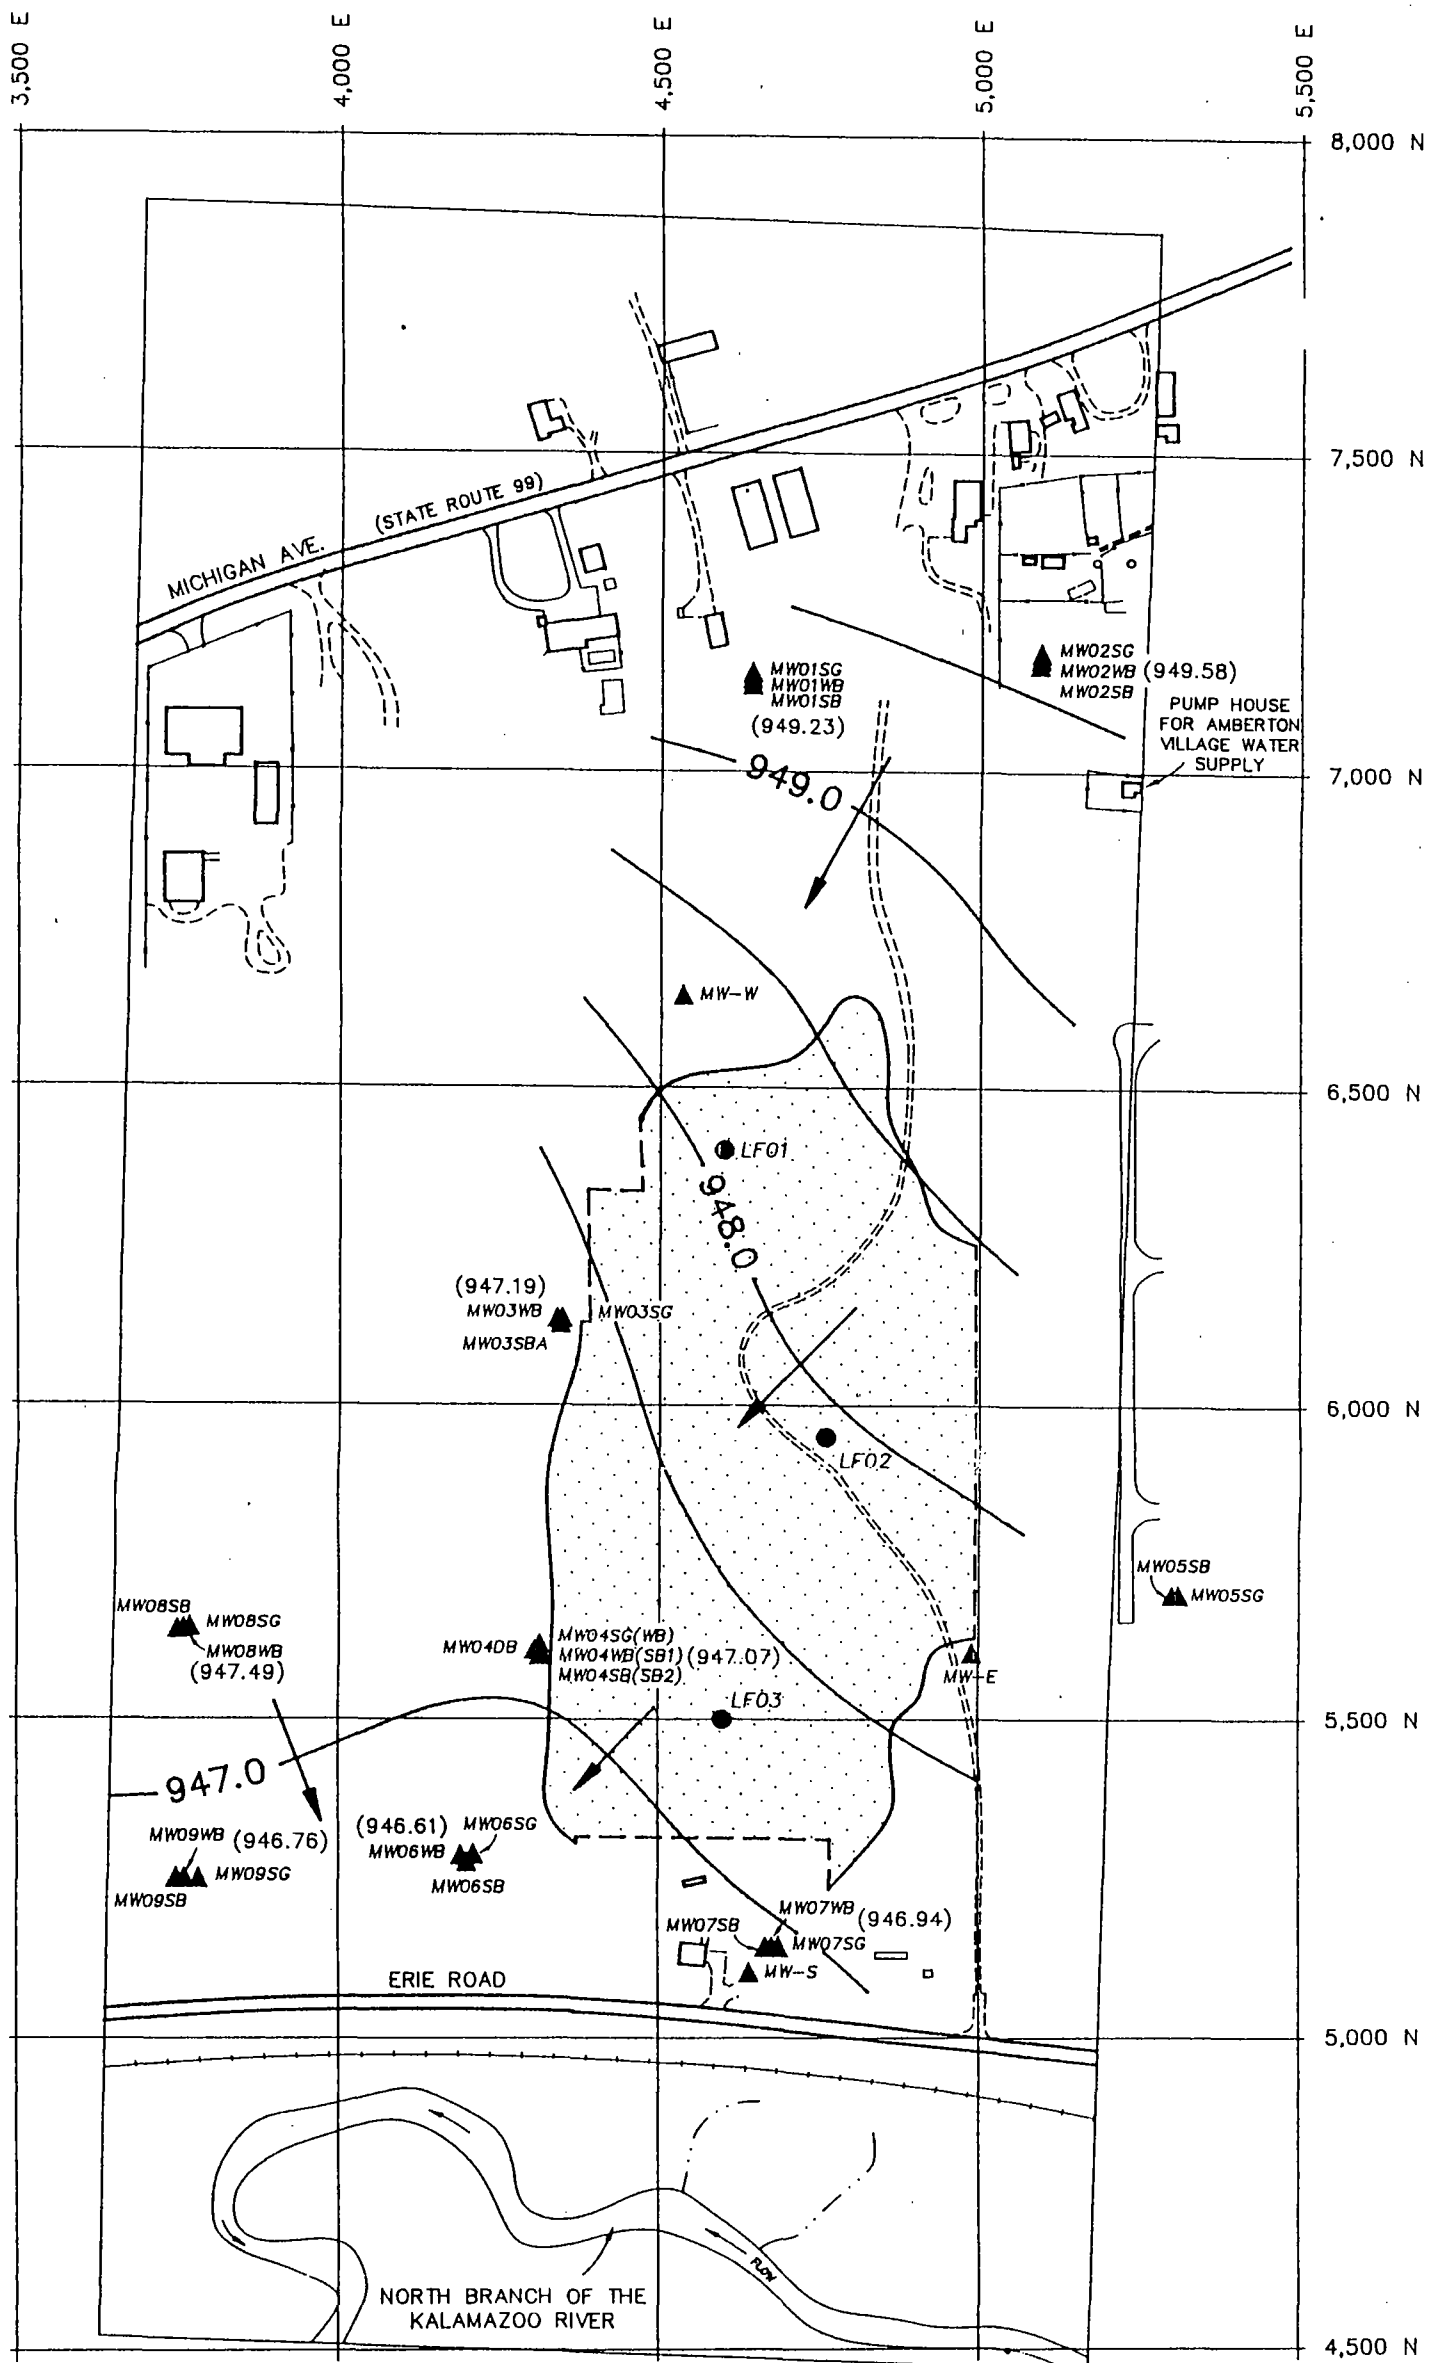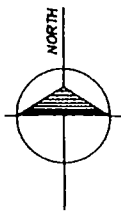

LEGEND

- APPROXIMATE LANDFILL BOUNDARY - (DASHED PORTIONS INDICATE THE SURVEY GRID BOUNDARY)
- UNPAVED ROAD
- INTERMITTENT STREAM
- RAILROAD TRACK
- MONITORING WELL LOCATION
- LEACHATE WELL LOCATION
- GROUND WATER CONTOUR
- GROUND WATER ELEVATION
- DIRECTION OF GROUND WATER FLOW

WATER LEVELS WERE MEASURED
IN WB-SERIES WELLS ON
DECEMBER 22, 1992.

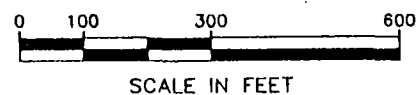

SCALE IN FEET



WBED-DEC
LVP042293

FIGURE 41 WEATHERED BEDROCK GROUND WATER FLOW MAP (DECEMBER 22, 1992)

ALBION-SHERIDAN TOWNSHIP LANDFILL
ALBION, MICHIGAN

APRIL, 1993


04011.03

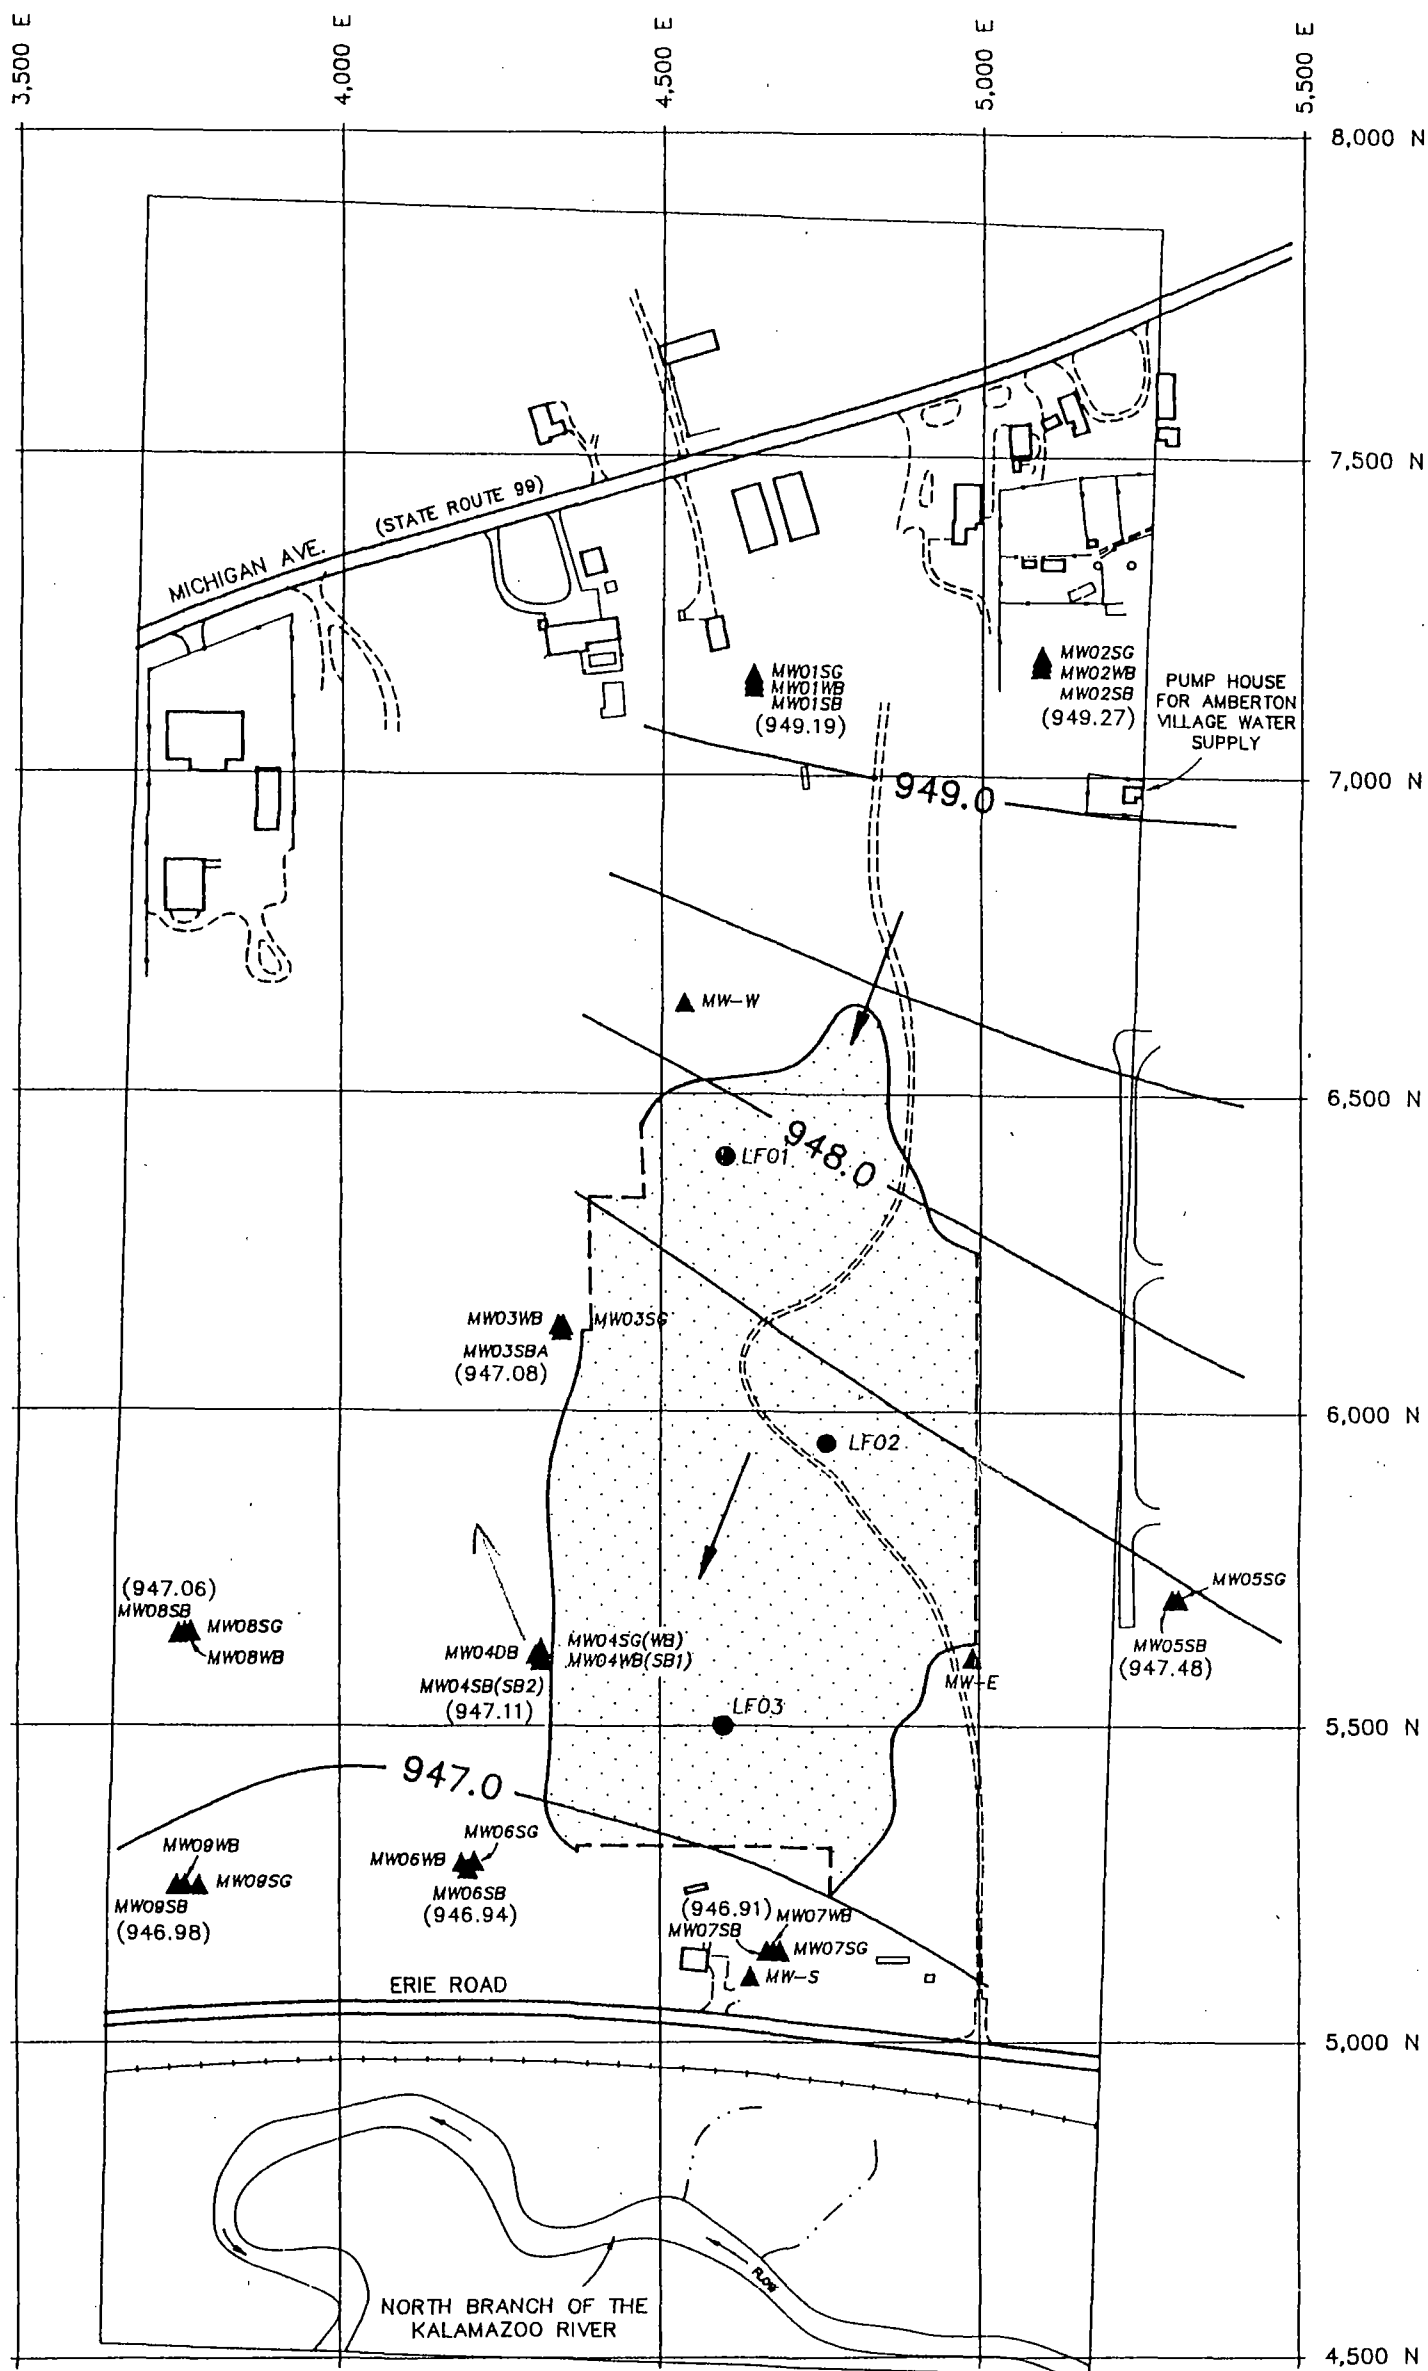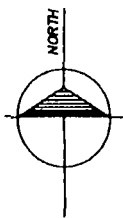

LEGEND

- APPROXIMATE LANDFILL BOUNDARY (DASHED PORTIONS INDICATE THE SURVEY GRID BOUNDARY)
- UNPAVED ROAD
- INTERMITTENT STREAM
- RAILROAD TRACK
- MONITORING WELL LOCATION
- LEACHATE WELL LOCATION
- GROUND WATER CONTOUR
- GROUND WATER ELEVATION
- DIRECTION OF GROUND WATER FLOW

WATER LEVELS WERE MEASURED
IN SB-SERIES WELLS ON
DECEMBER 22, 1992.

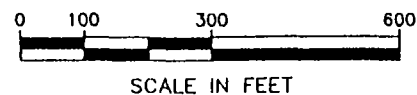

SCALE IN FEET

SBED-DEC
LVP042293

FIGURE 44 SHALLOW BEDROCK GROUND WATER FLOW MAP (DECEMBER 22, 1992)

ALBION-SHERIDAN TOWNSHIP LANDFILL
ALBION, MICHIGAN


APRIL, 1993

04011.03

SWL

Clashed

Jan. '93

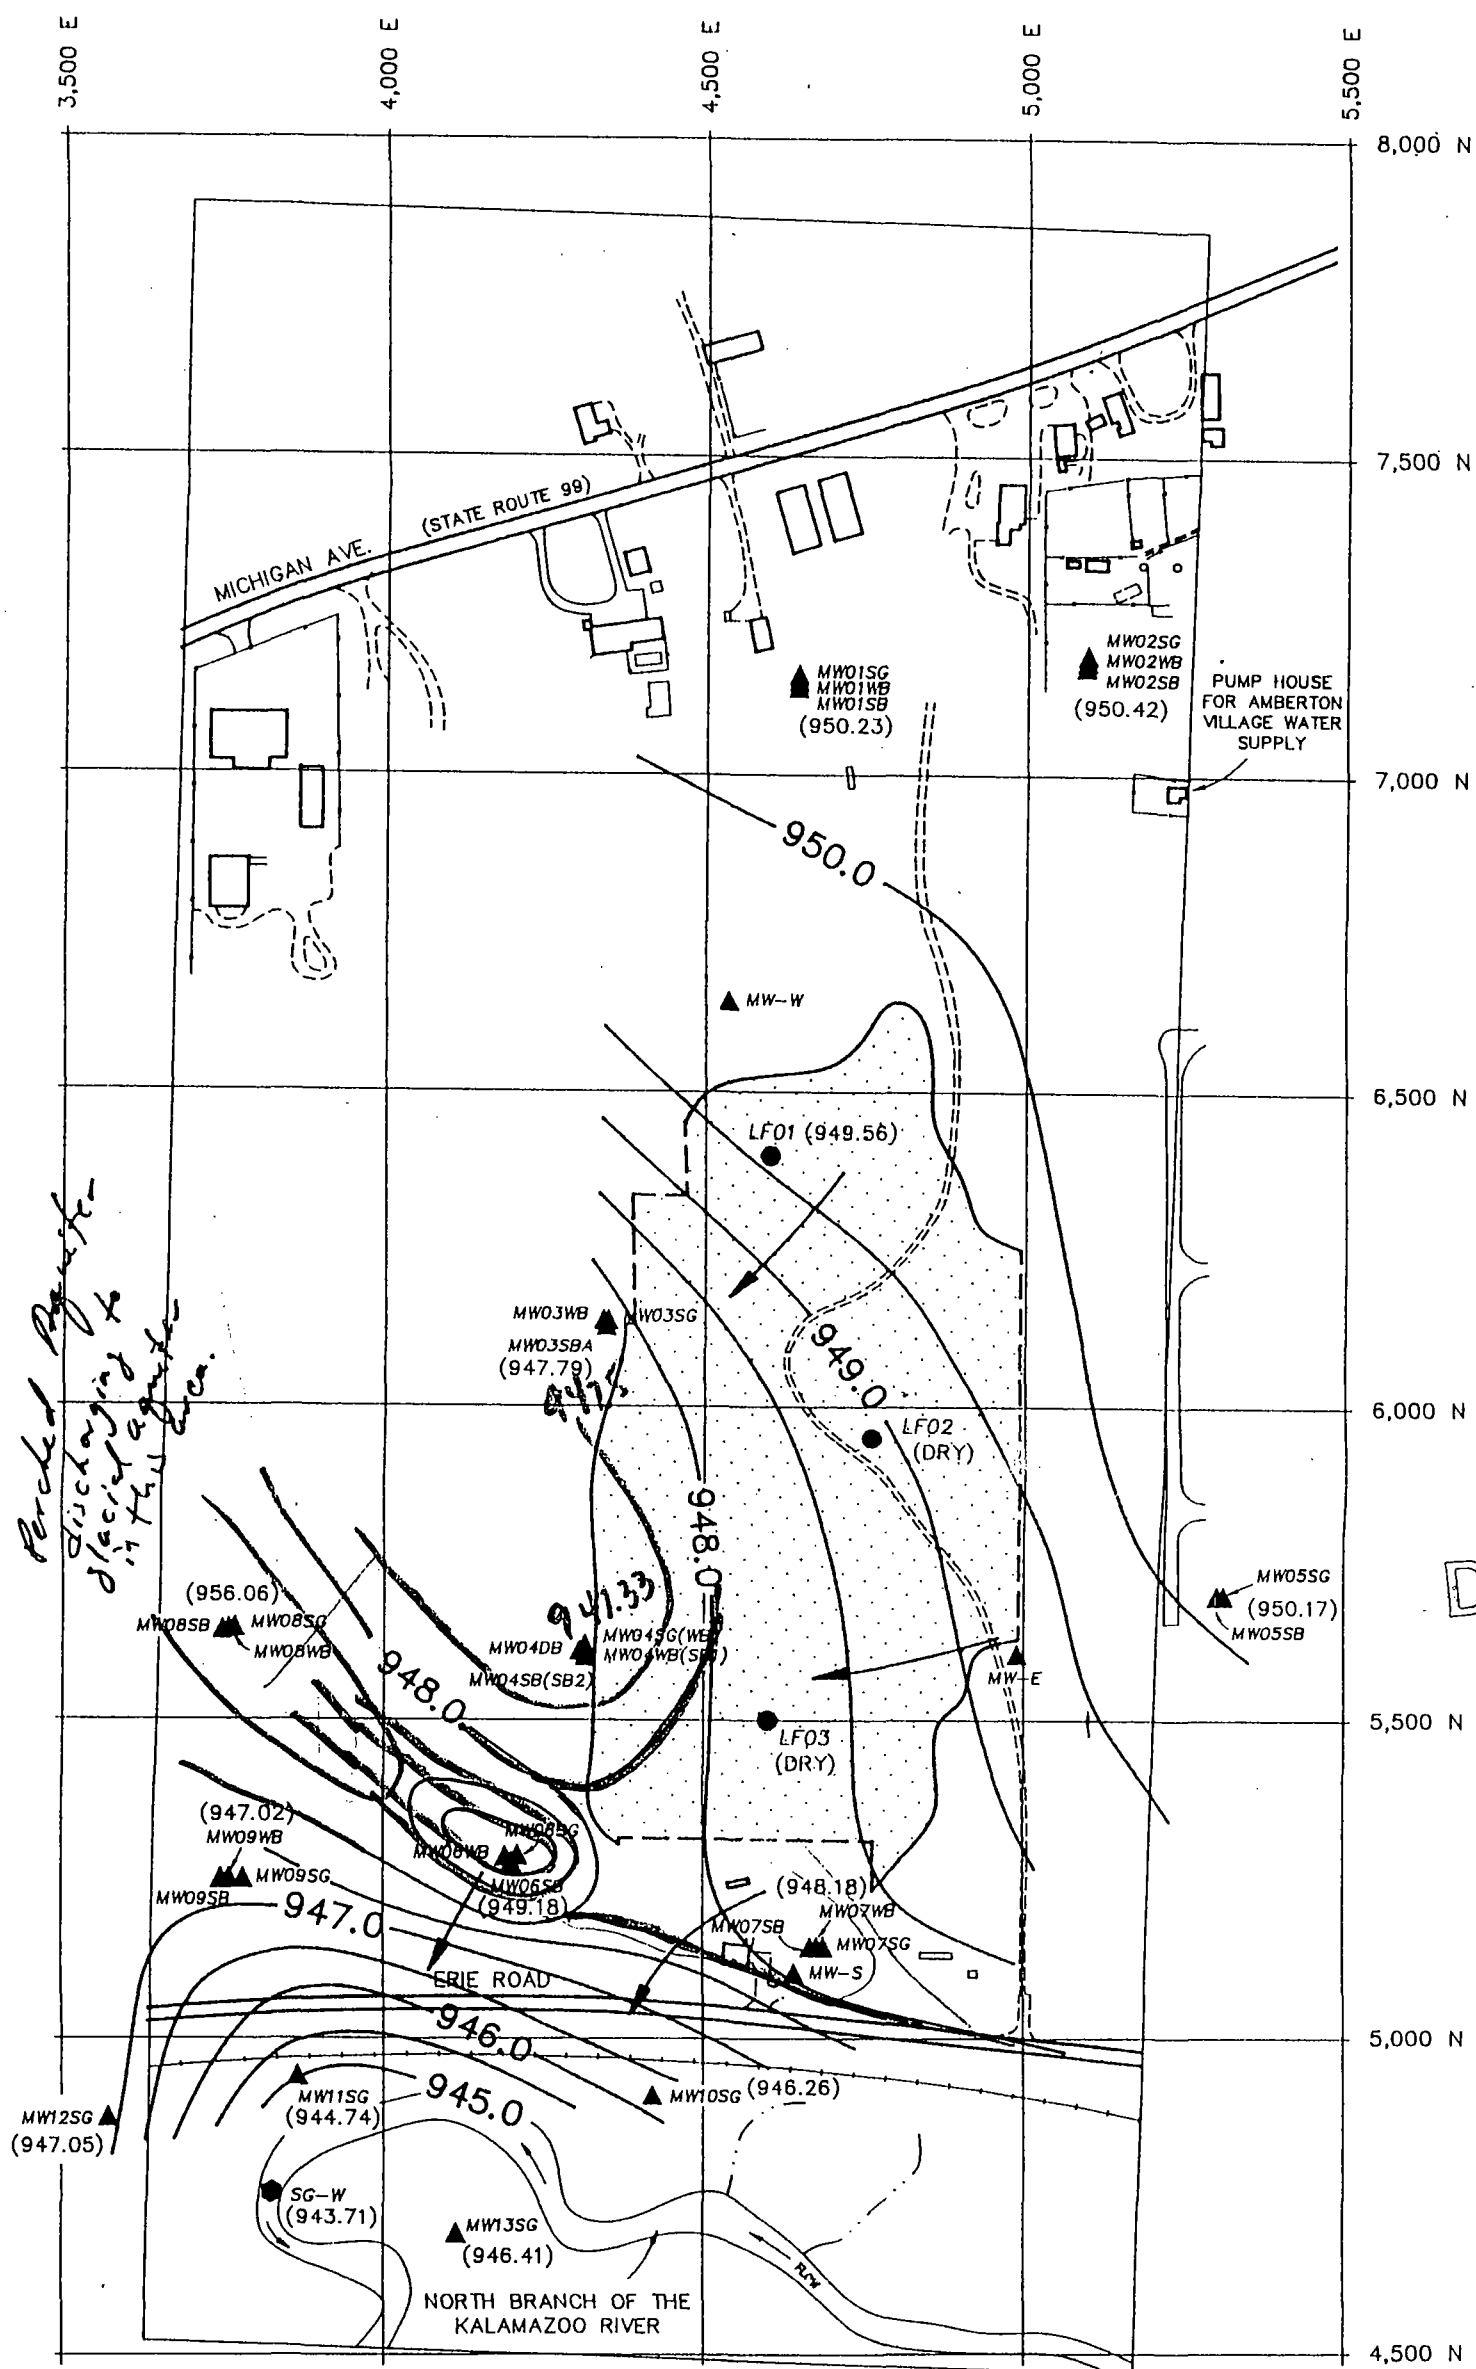

DRAFT


LEGEND




APPROXIMATE LANDFILL BOUNDARY
(DASHED PORTIONS INDICATE THE
SURVEY GRID BOUNDARY)



UNPAVED ROAD

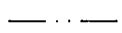

INTERMITTENT STREAM

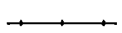

RAILROAD TRACK



MONITORING WELL LOCATION



LEACHATE WELL LOCATION



STAFF GAUGE LOCATION

948.0 —

GROUND WATER CONTOUR


(947.79)

GROUND WATER ELEVATION



DIRECTION OF GROUND WATER FLOW

WATER LEVELS WERE MEASURED
IN SG-SERIES WELLS ON
JANUARY 28, 1993.

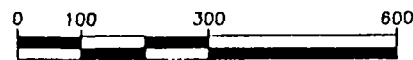

SCALE IN FEET

UGW-JAN
LVP042093



FIGURE 39

UNCONSOLIDATED GROUND WATER FLOW MAP (JANUARY 28, 1993)

ALBION-SHERIDAN TOWNSHIP LANDFILL
ALBION, MICHIGAN

APRIL, 1993


04011.03

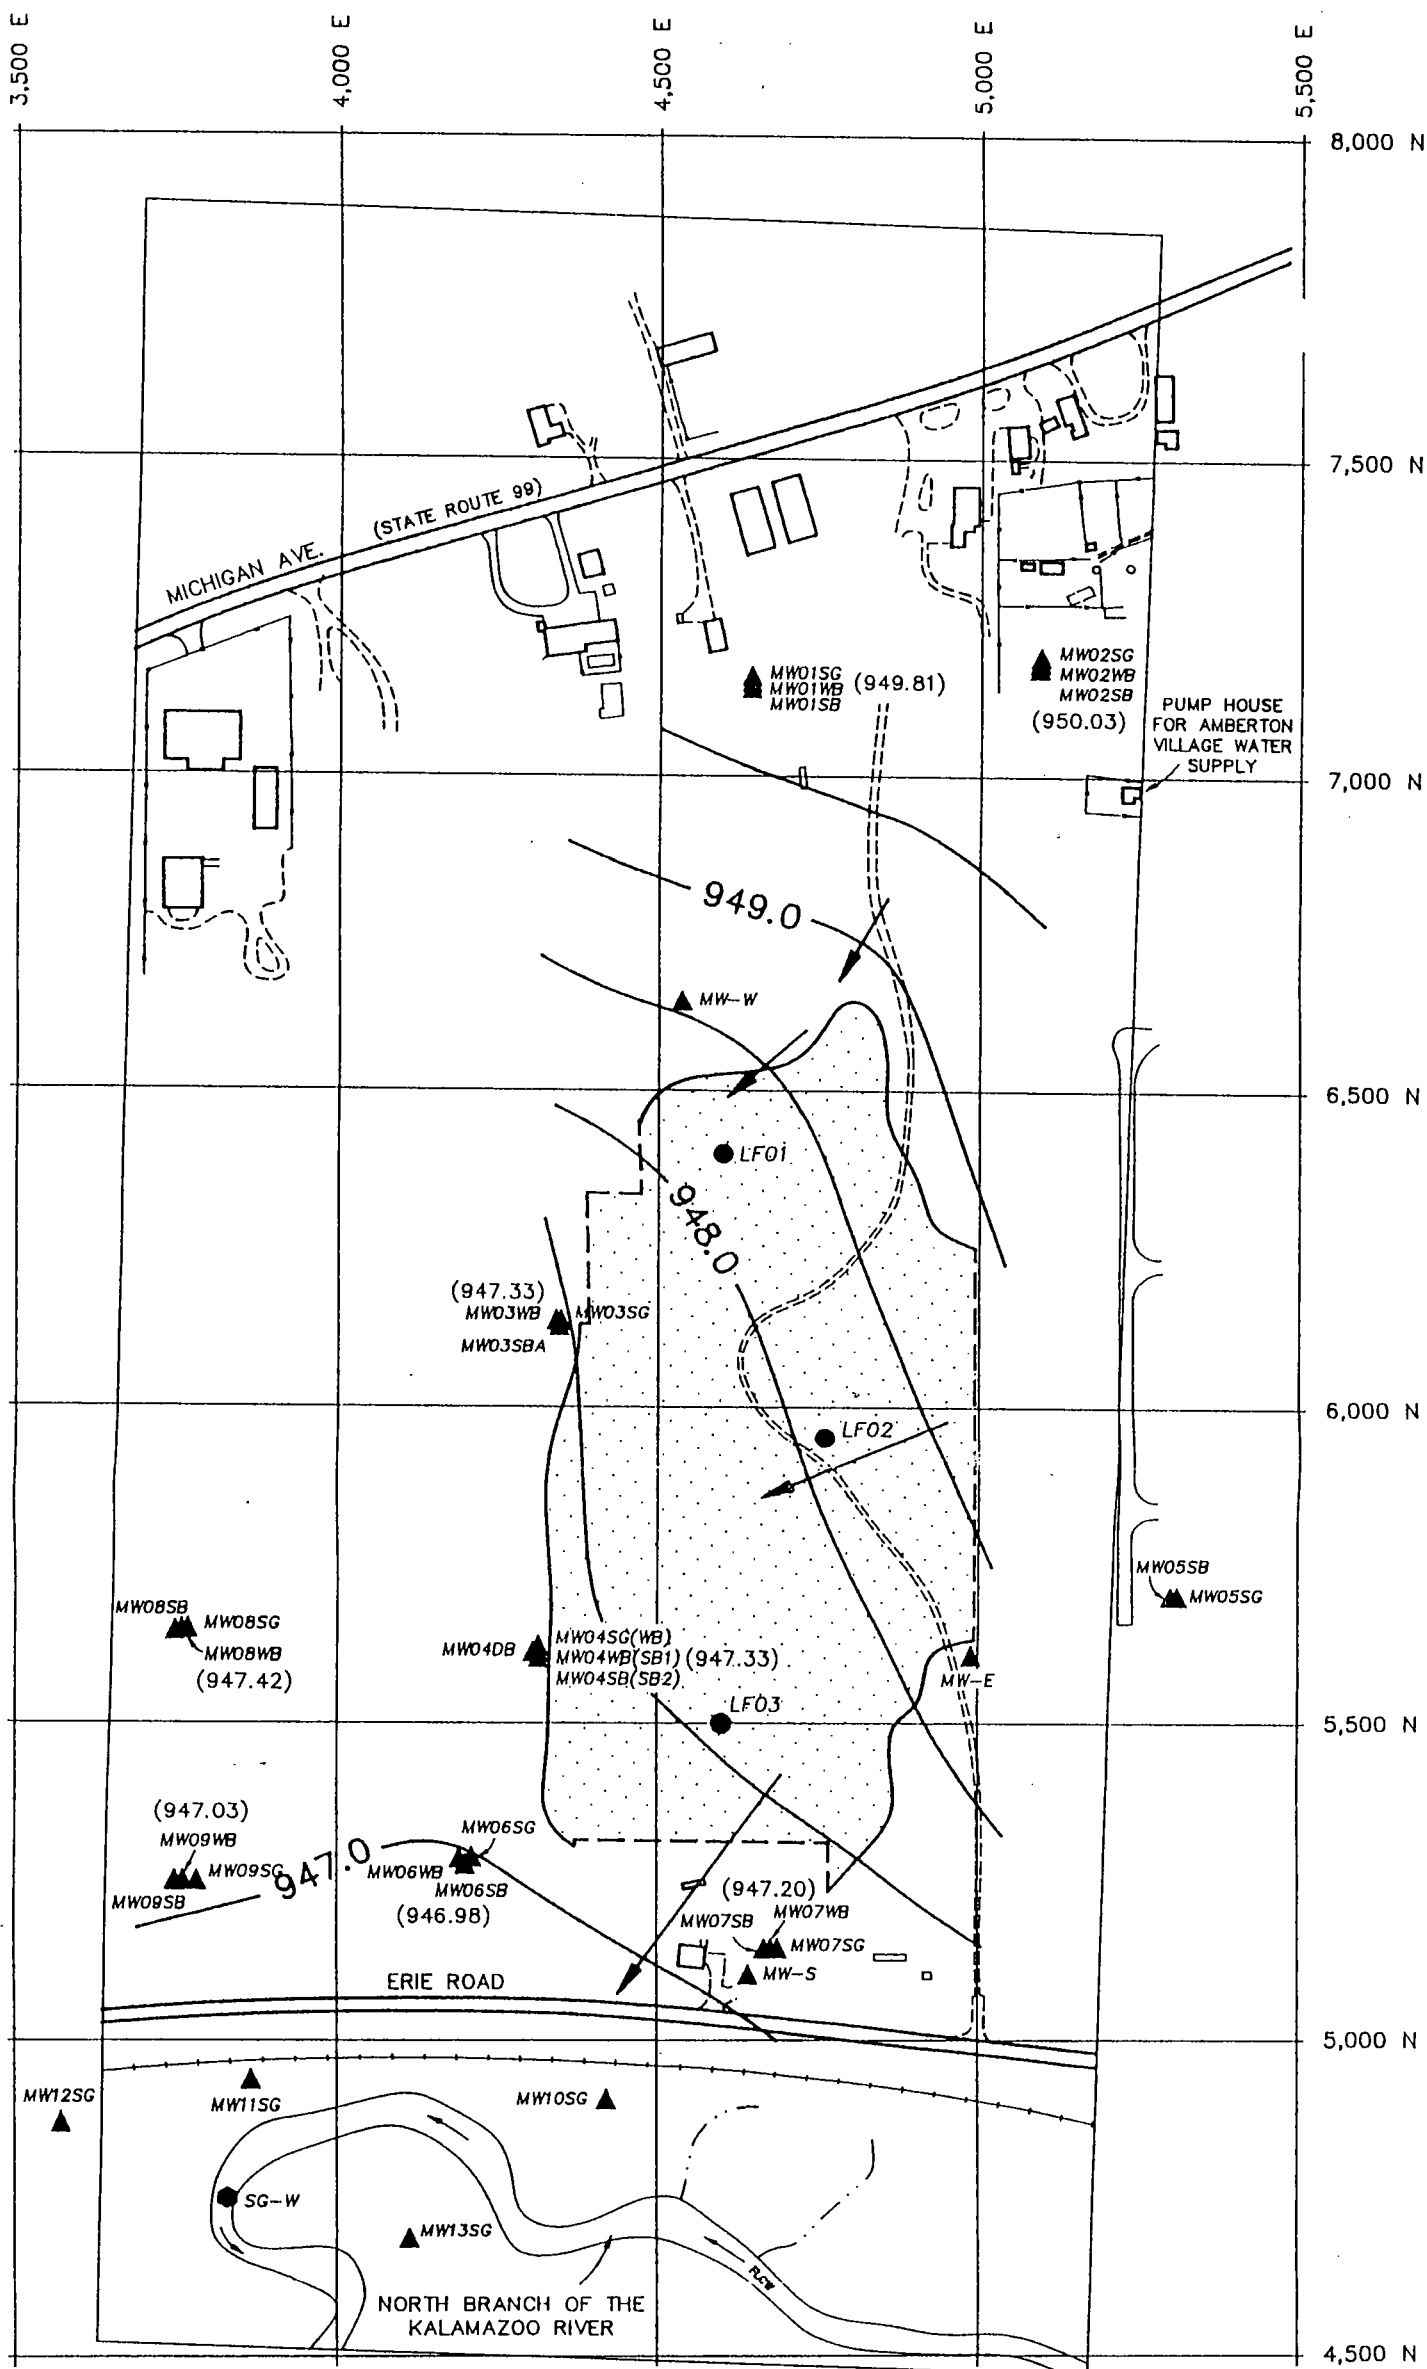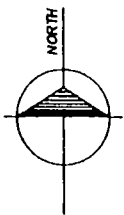

LEGEND



 
APPROXIMATE LANDFILL BOUNDARY
(DASHED PORTIONS INDICATE THE
SURVEY GRID BOUNDARY)



UNPAVED ROAD



 INTERMITTENT STREAM



RAILROAD TRACK



MONITORING WELL LOCATION



LEACHATE WELL LOCATION



STAFF GAUGE LOCATION

948.0

GROUND WATER CONTOUR


(947.33)

GROUND WATER ELEVATION



DIRECTION OF GROUND WATER FLOW

WATER LEVELS WERE MEASURED
IN WB-SERIES WELLS ON
JANUARY 28, 1993

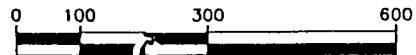

SCALE IN FEET

WBED-JAN
LVP042293


FIGURE 42

WEATHERED BEDROCK GROUND WATER FLOW MAP (JANUARY 28, 1993)

ALBION-SHERIDAN TOWNSHIP LANDFILL
ALBION, MICHIGAN

APRIL, 1993


04011.03

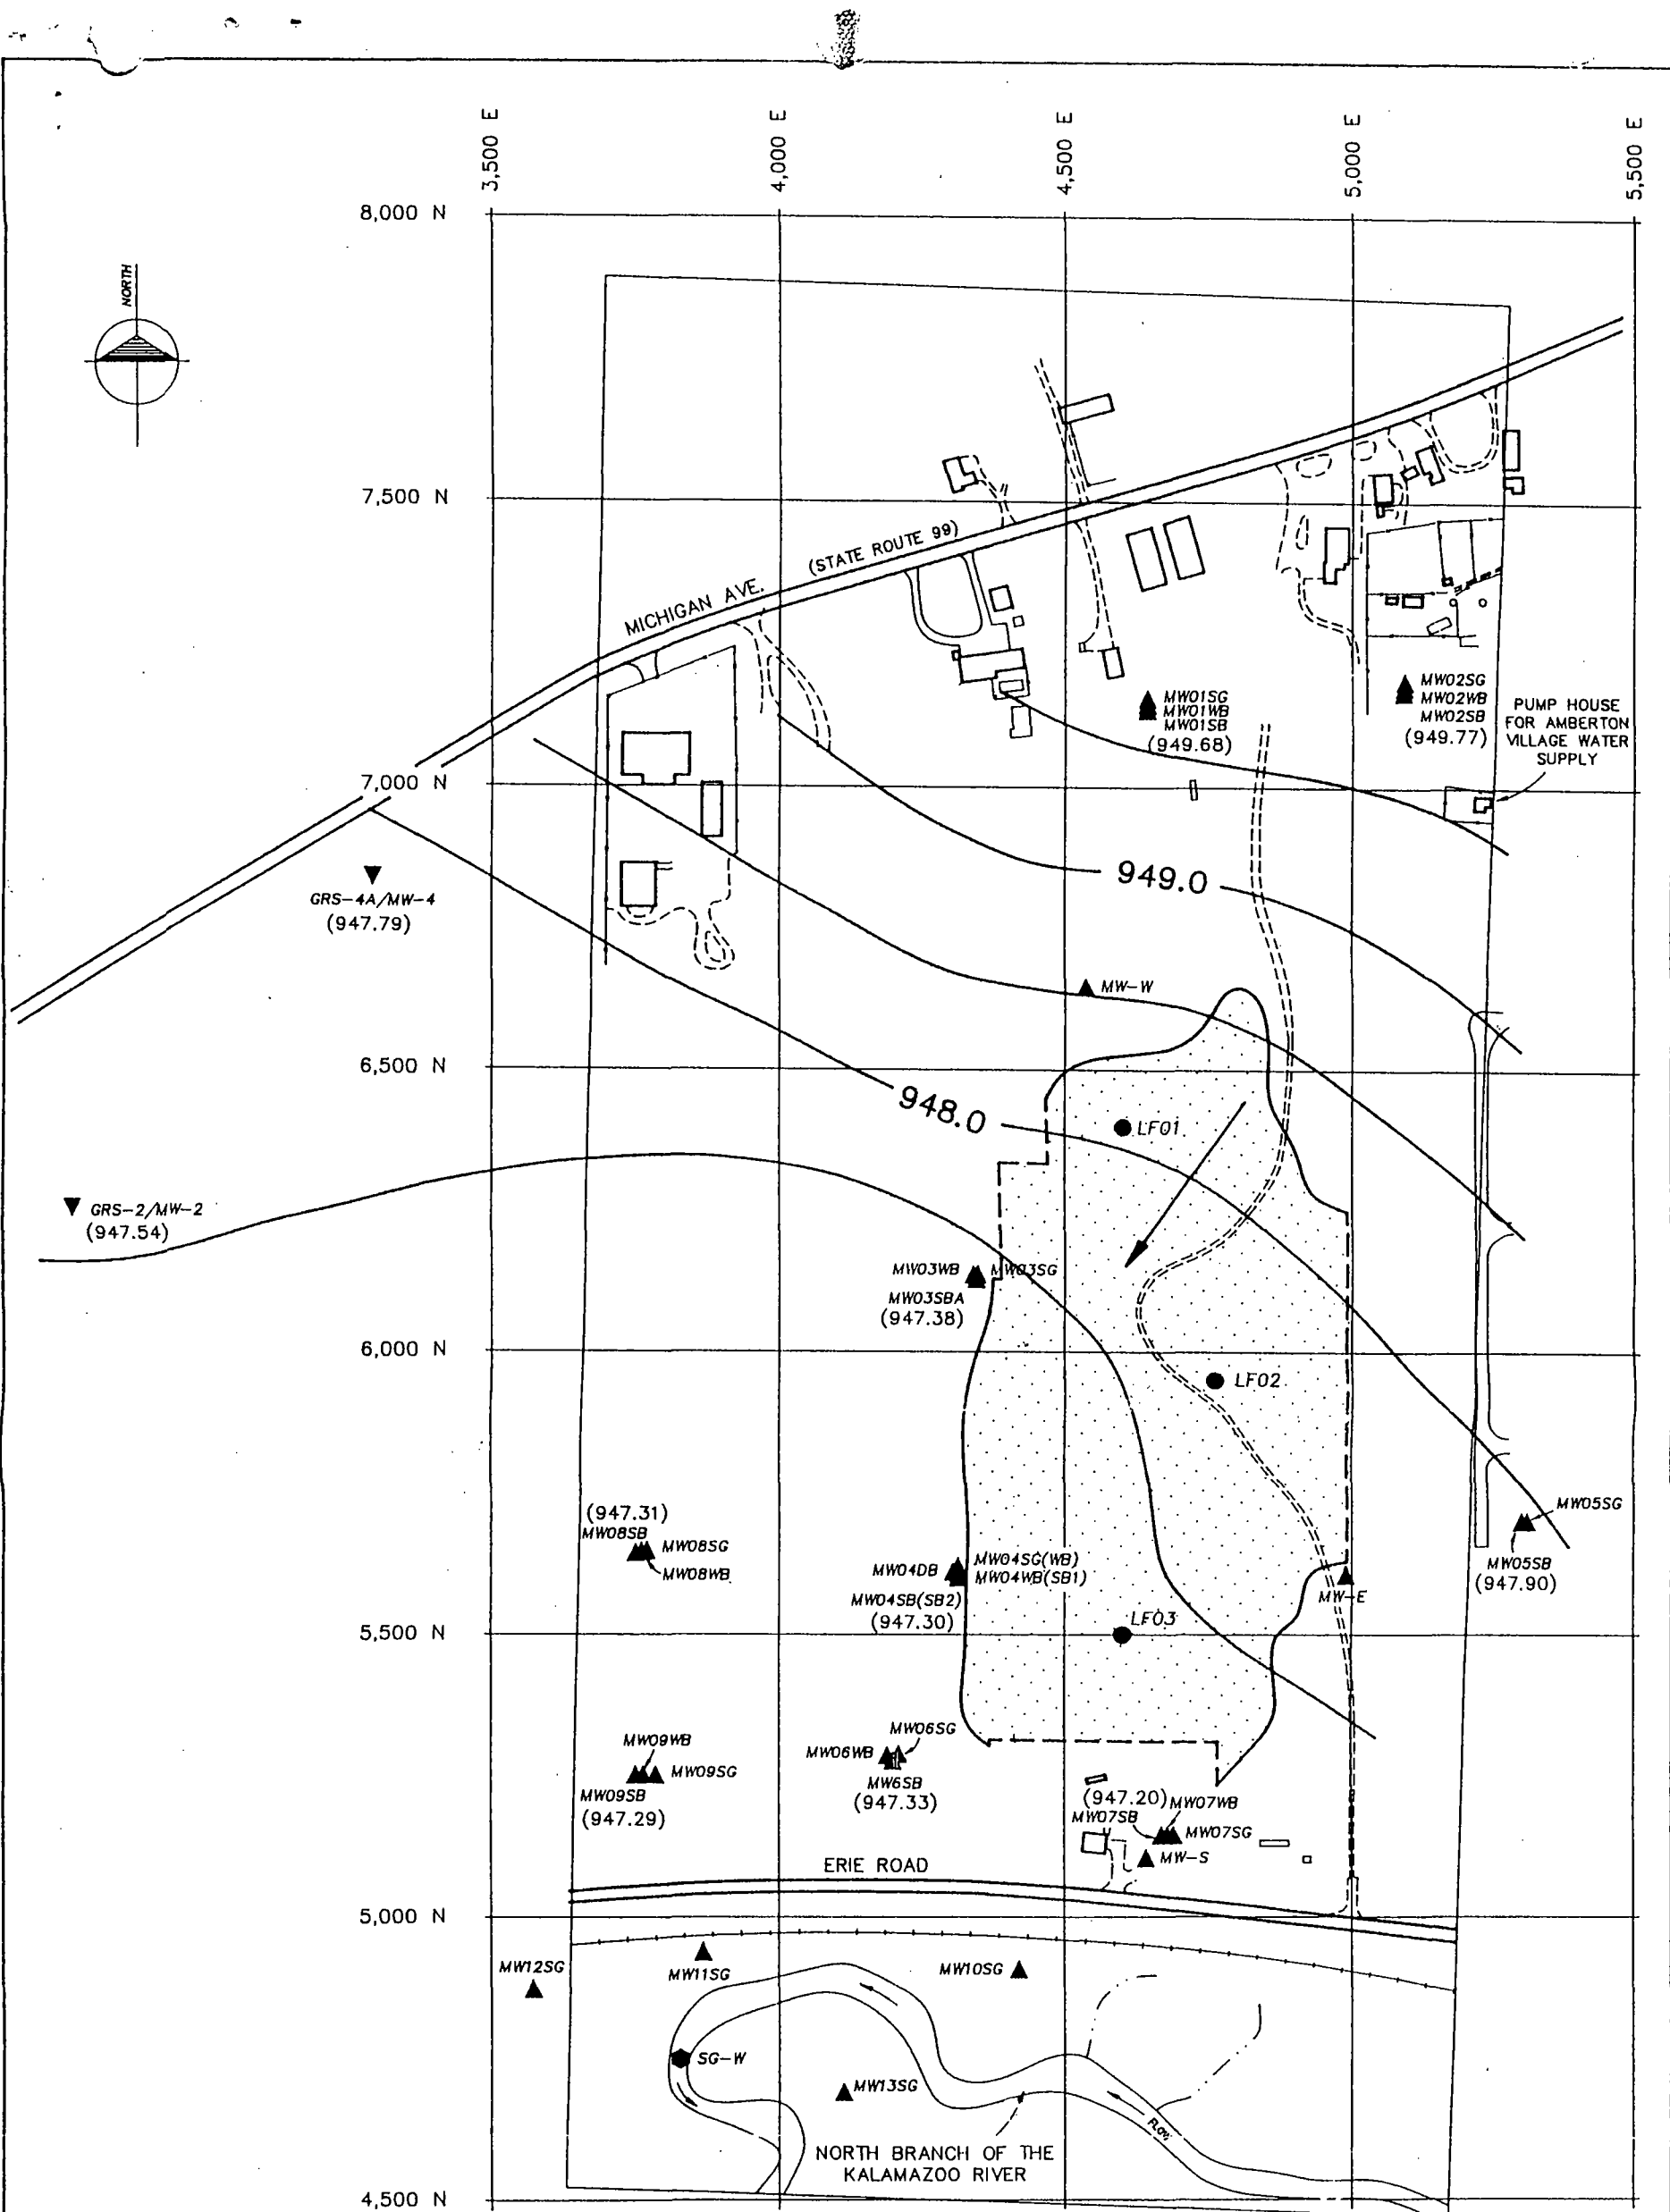

LEGEND

- APPROXIMATE LANDFILL BOUNDARY (DASHED PORTIONS INDICATE THE SURVEY GRID BOUNDARY)
- UNPAVED ROAD
- INTERMITTENT STREAM
- RAILROAD TRACK
- MONITORING WELL LOCATION
- LEACHATE WELL LOCATION
- GRS WELL LOCATION
- STAFF GAUGE LOCATION
- GROUND WATER CONTOUR
- GROUND WATER ELEVATION
- DIRECTION OF GROUND WATER FLOW

WATER LEVELS WERE MEASURED IN SB-SERIES WELLS ON JANUARY 28, 1993.

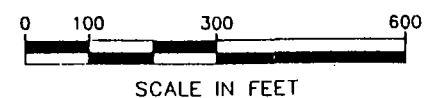

SCALE IN FEET

SBED-JAN LVP052093

FIGURE 45
SHALLOW BEDROCK
GROUND WATER FLOW MAP
(JANUARY 28, 1993)
ALBION-SHERIDAN TOWNSHIP LANDFILL
ALBION, MICHIGAN



MAY, 1993

04011.03

SWL

Glacial


March 93

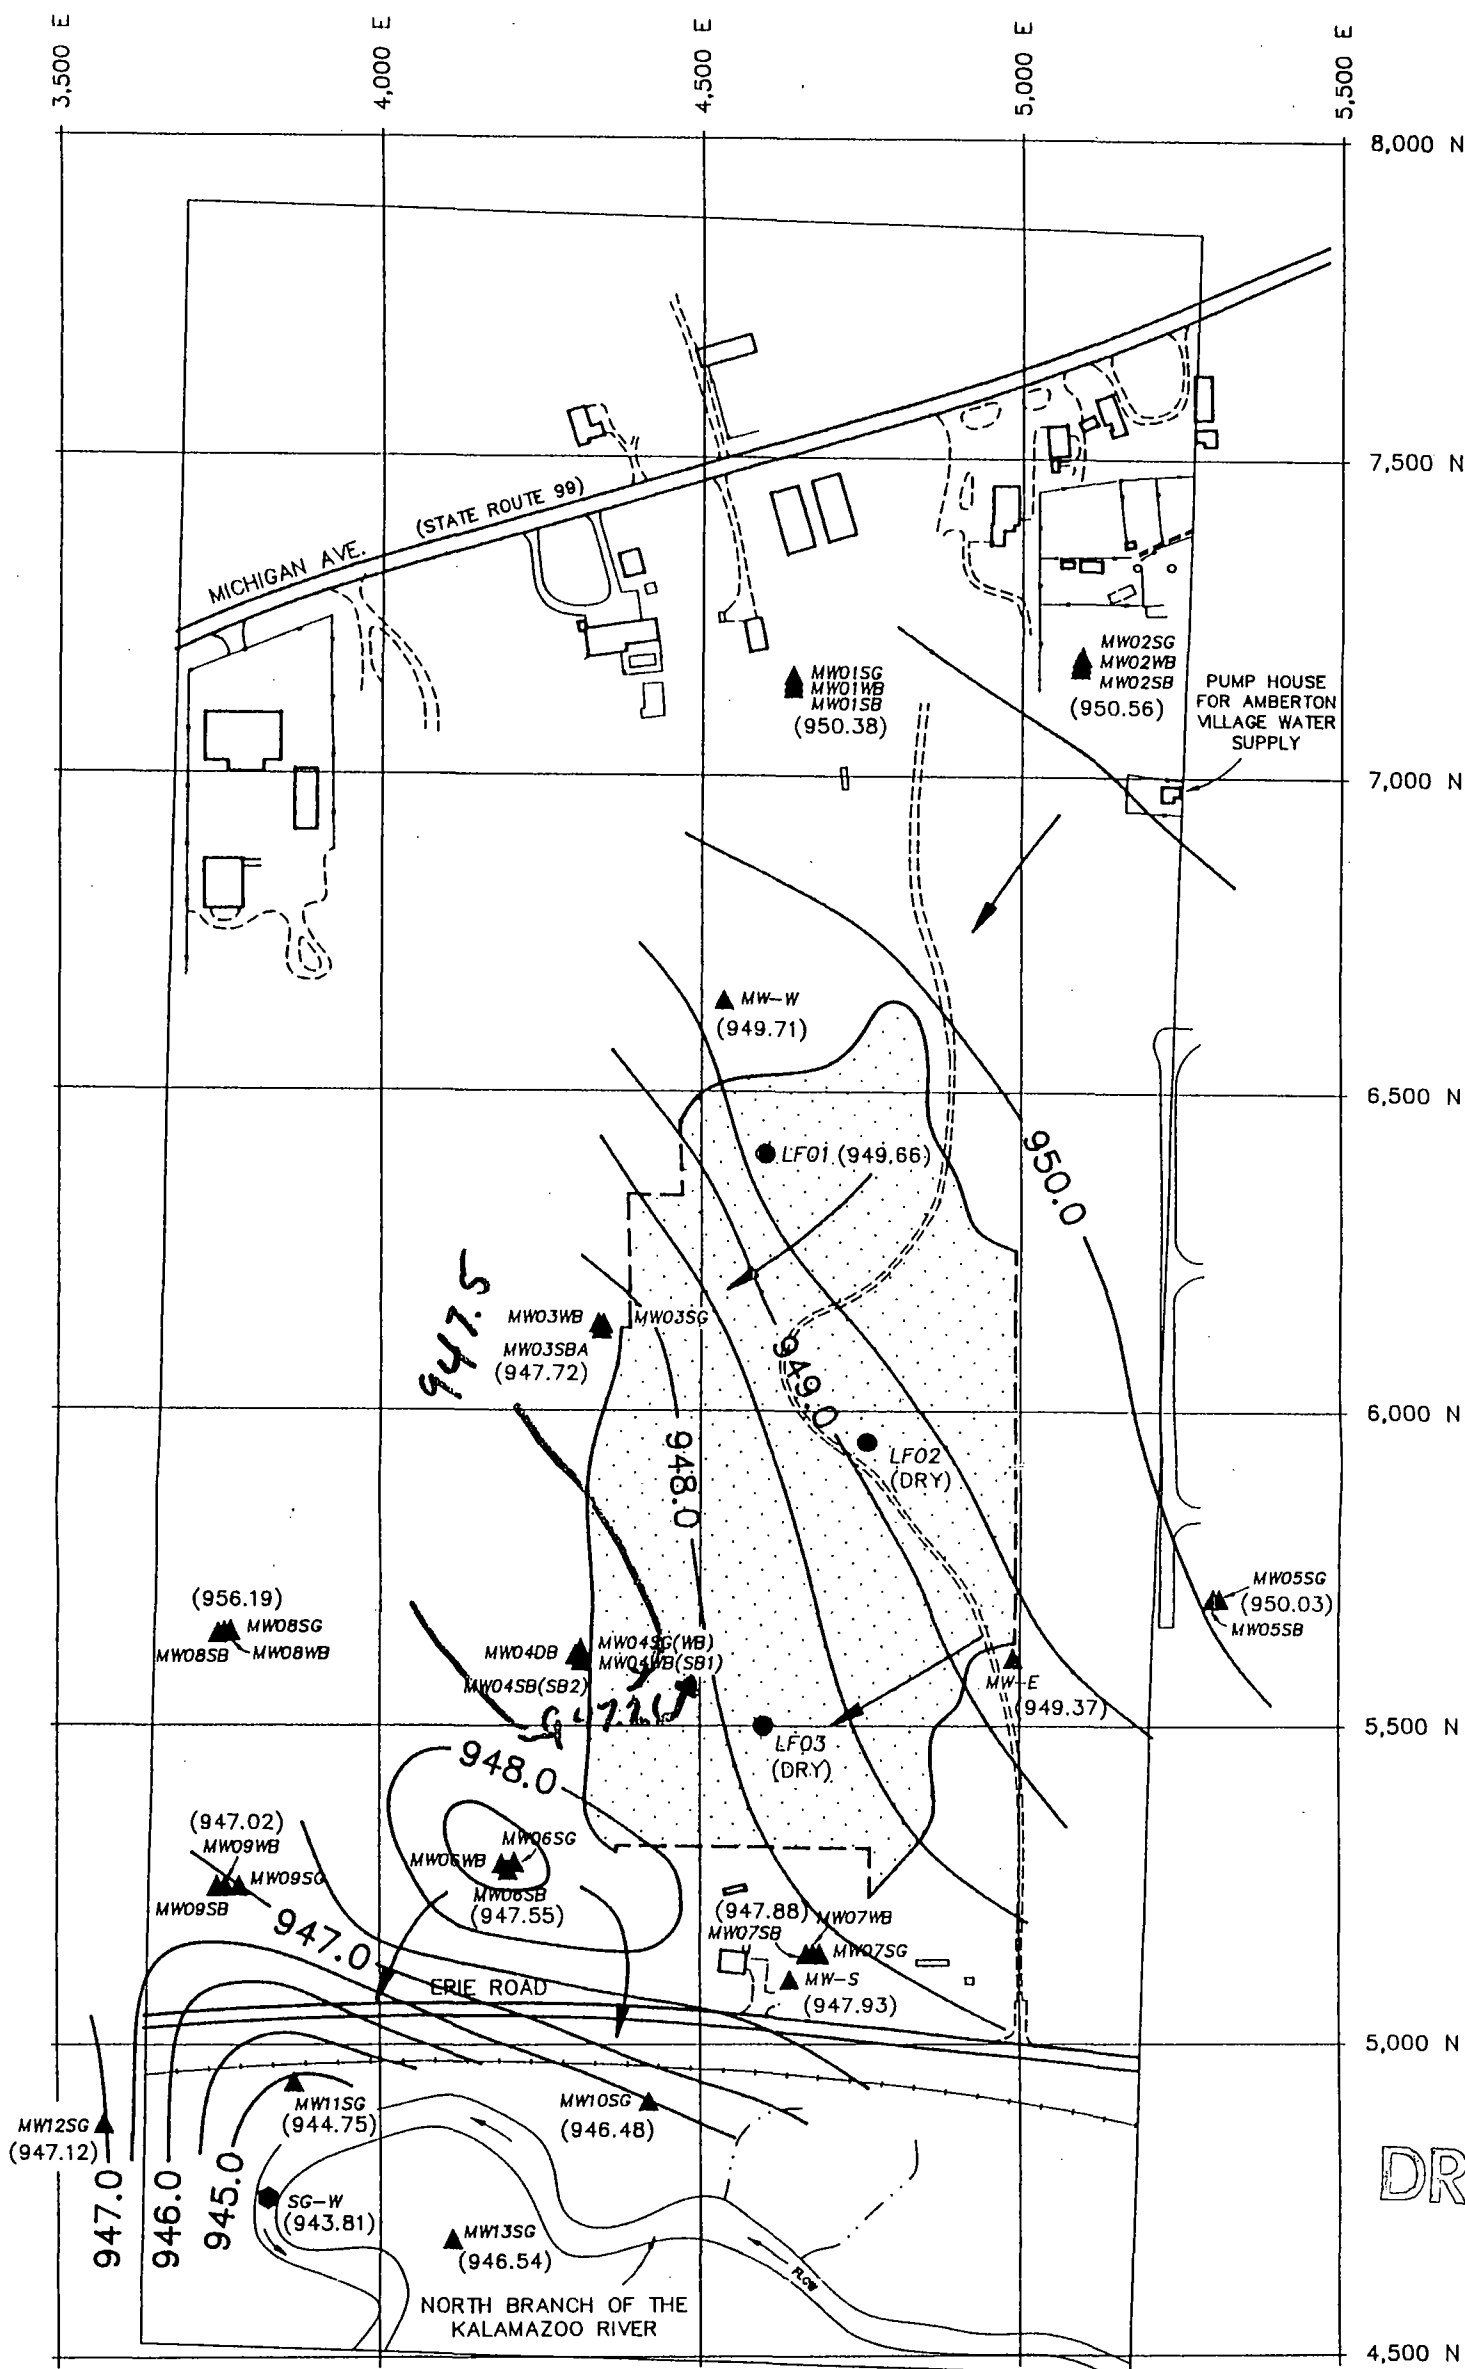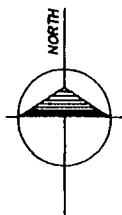

LEGEND

- APPROXIMATE LANDFILL BOUNDARY - (DASHED PORTIONS INDICATE THE SURVEY GRID BOUNDARY)
- UNPAVED ROAD
- INTERMITTENT STREAM
- RAILROAD TRACK
- MONITORING WELL LOCATION
- LEACHATE WELL LOCATION
- LEACHATE WELL LOCATION
- GROUND WATER CONTOUR
- GROUND WATER ELEVATION
- DIRECTION OF GROUND WATER FLOW

WATER LEVELS WERE MEASURED IN SG-SERIES WELLS ON MARCH 8, 1993.


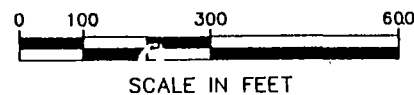


UGW-MAR
LVP042093

FIGURE 40
UNCONSOLIDATED
GROUND WATER FLOW MAP
(MARCH 8, 1993)
ALBION-SHERIDAN TOWNSHIP LANDFILL
ALBION, MICHIGAN

APRIL, 1993


04011.03

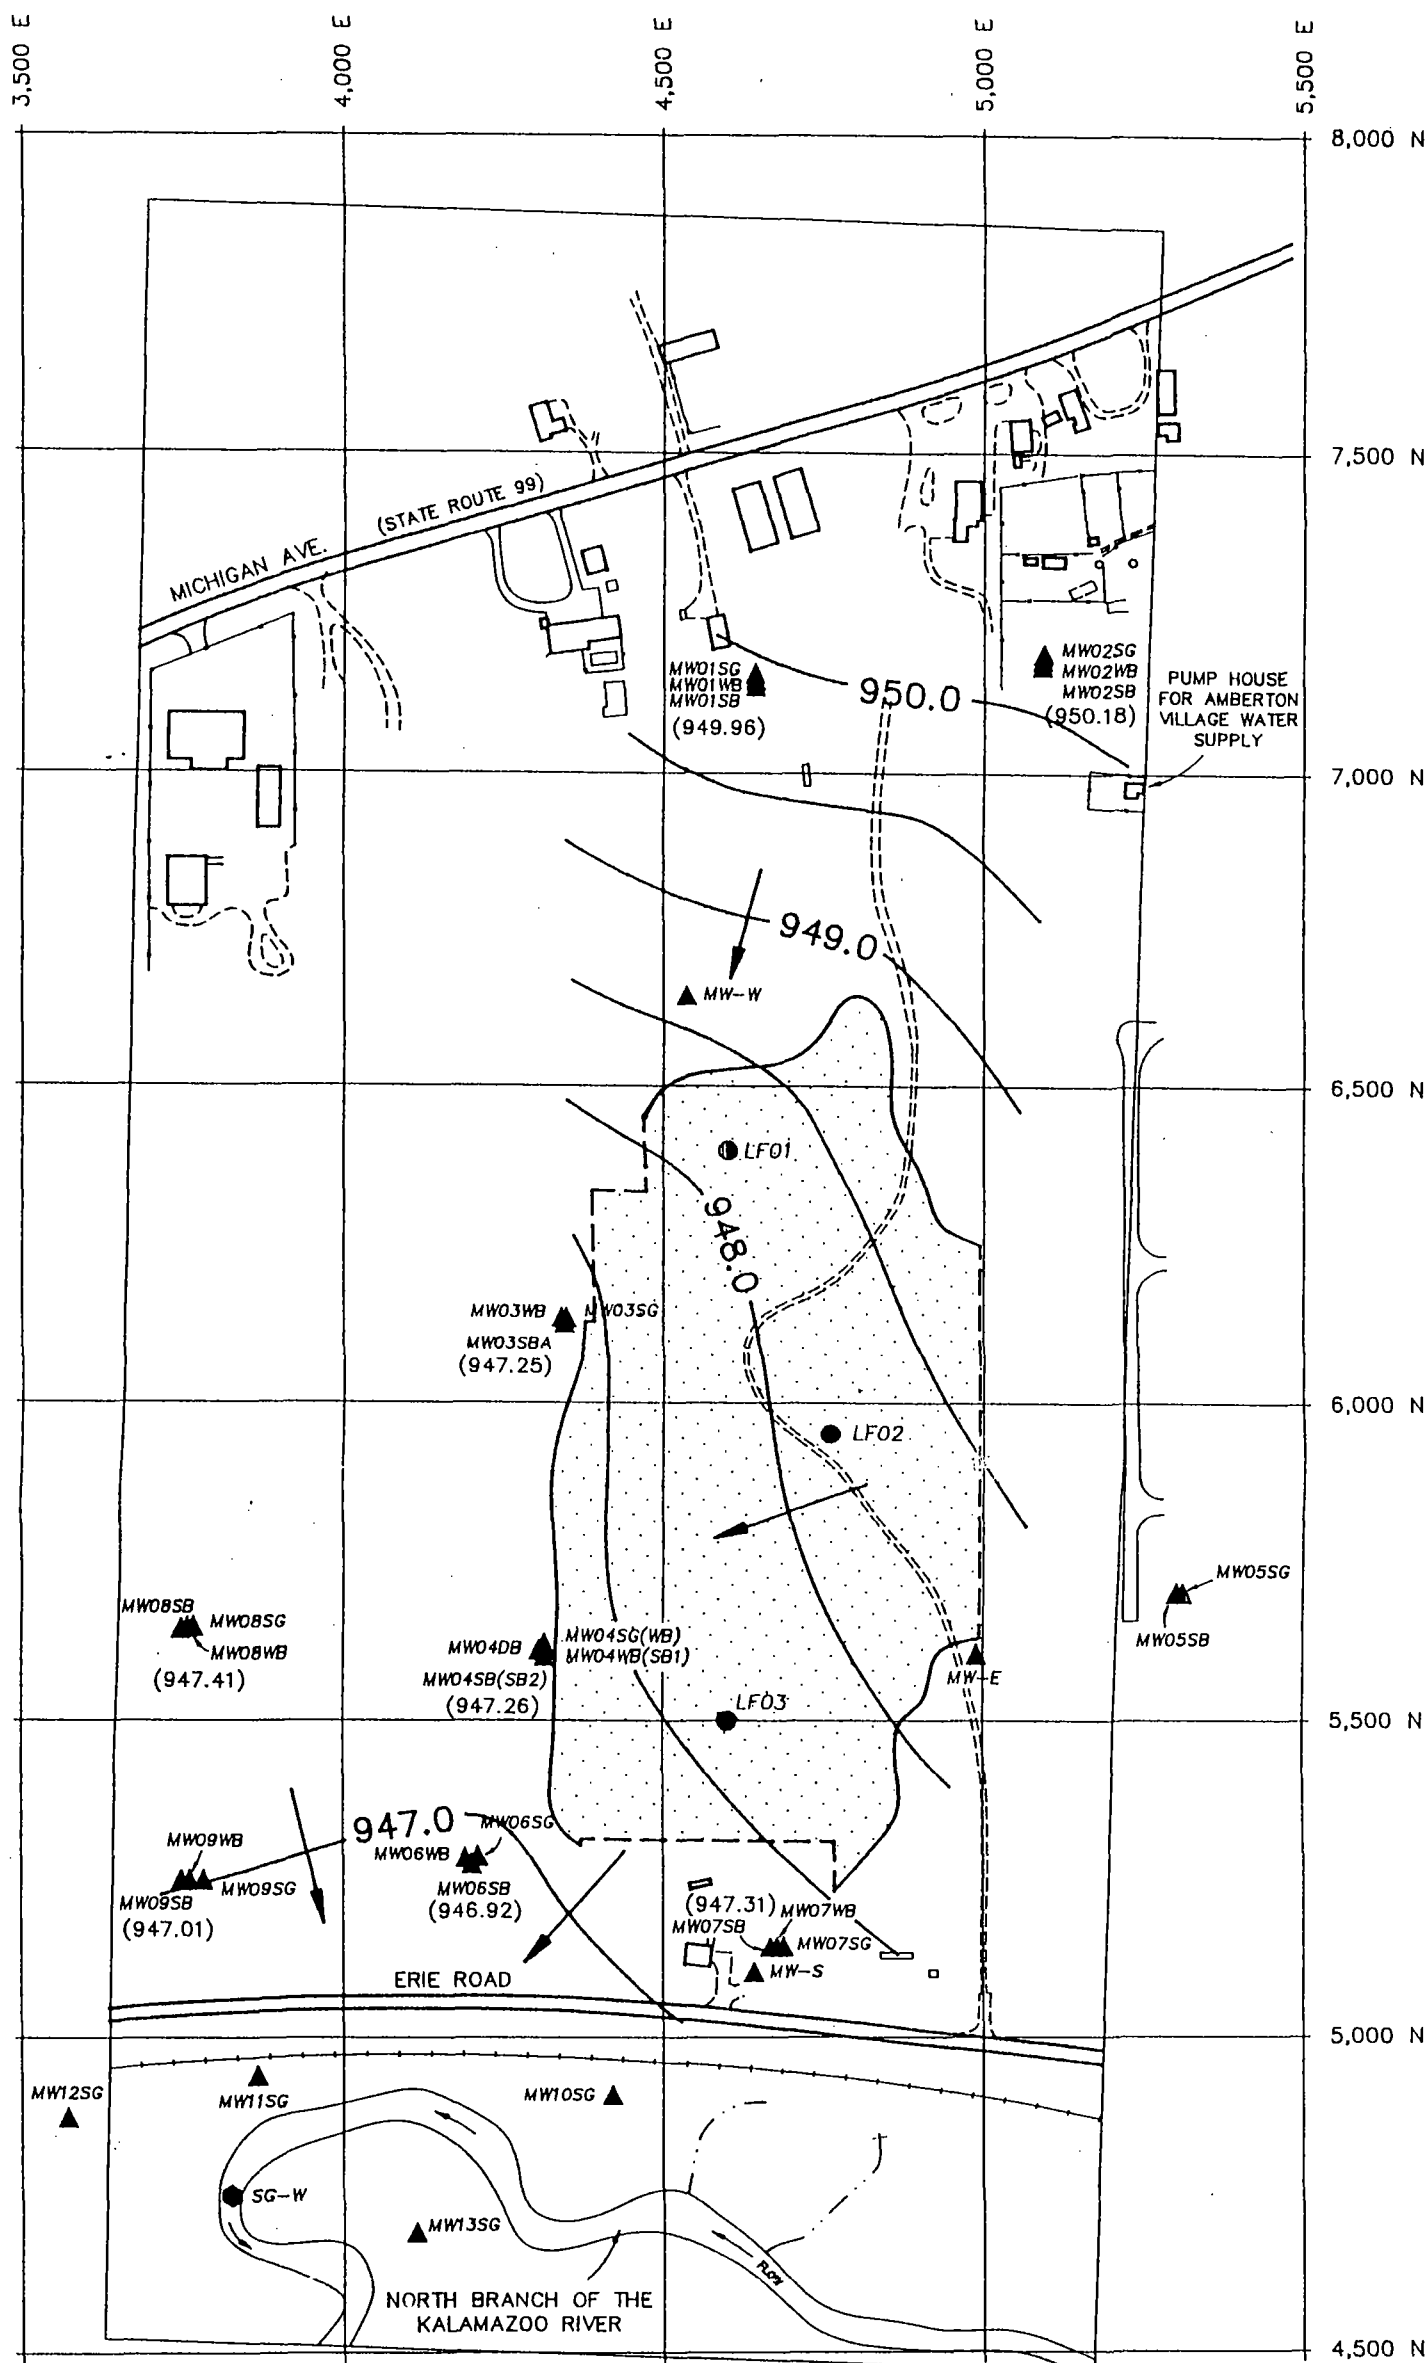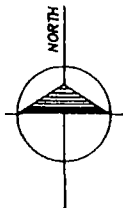

LEGEND

- APPROXIMATE LANDFILL BOUNDARY
- (DASHED PORTIONS INDICATE THE SURVEY GRID BOUNDARY)
- UNPAVED ROAD
- INTERMITTENT STREAM
- RAILROAD TRACK
- MONITORING WELL LOCATION
- LEACHATE WELL LOCATION
- STAFF GAUGE LOCATION
- GROUND WATER CONTOUR
948.0 - GROUND WATER ELEVATION
(947.26)
- DIRECTION OF GROUND WATER FLOW

WATER LEVELS WERE MEASURED
IN WB-SERIES WELLS ON
MARCH 8, 1993.

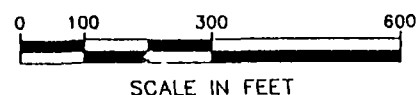

SCALE IN FEET


WBED-MAR
LVP042293

FIGURE 43 WEATHERED BEDROCK GROUND WATER FLOW MAP (MARCH 8, 1993)

ALBION-SHERIDAN TOWNSHIP LANDFILL
ALBION, MICHIGAN

APRIL, 1993


04011.03

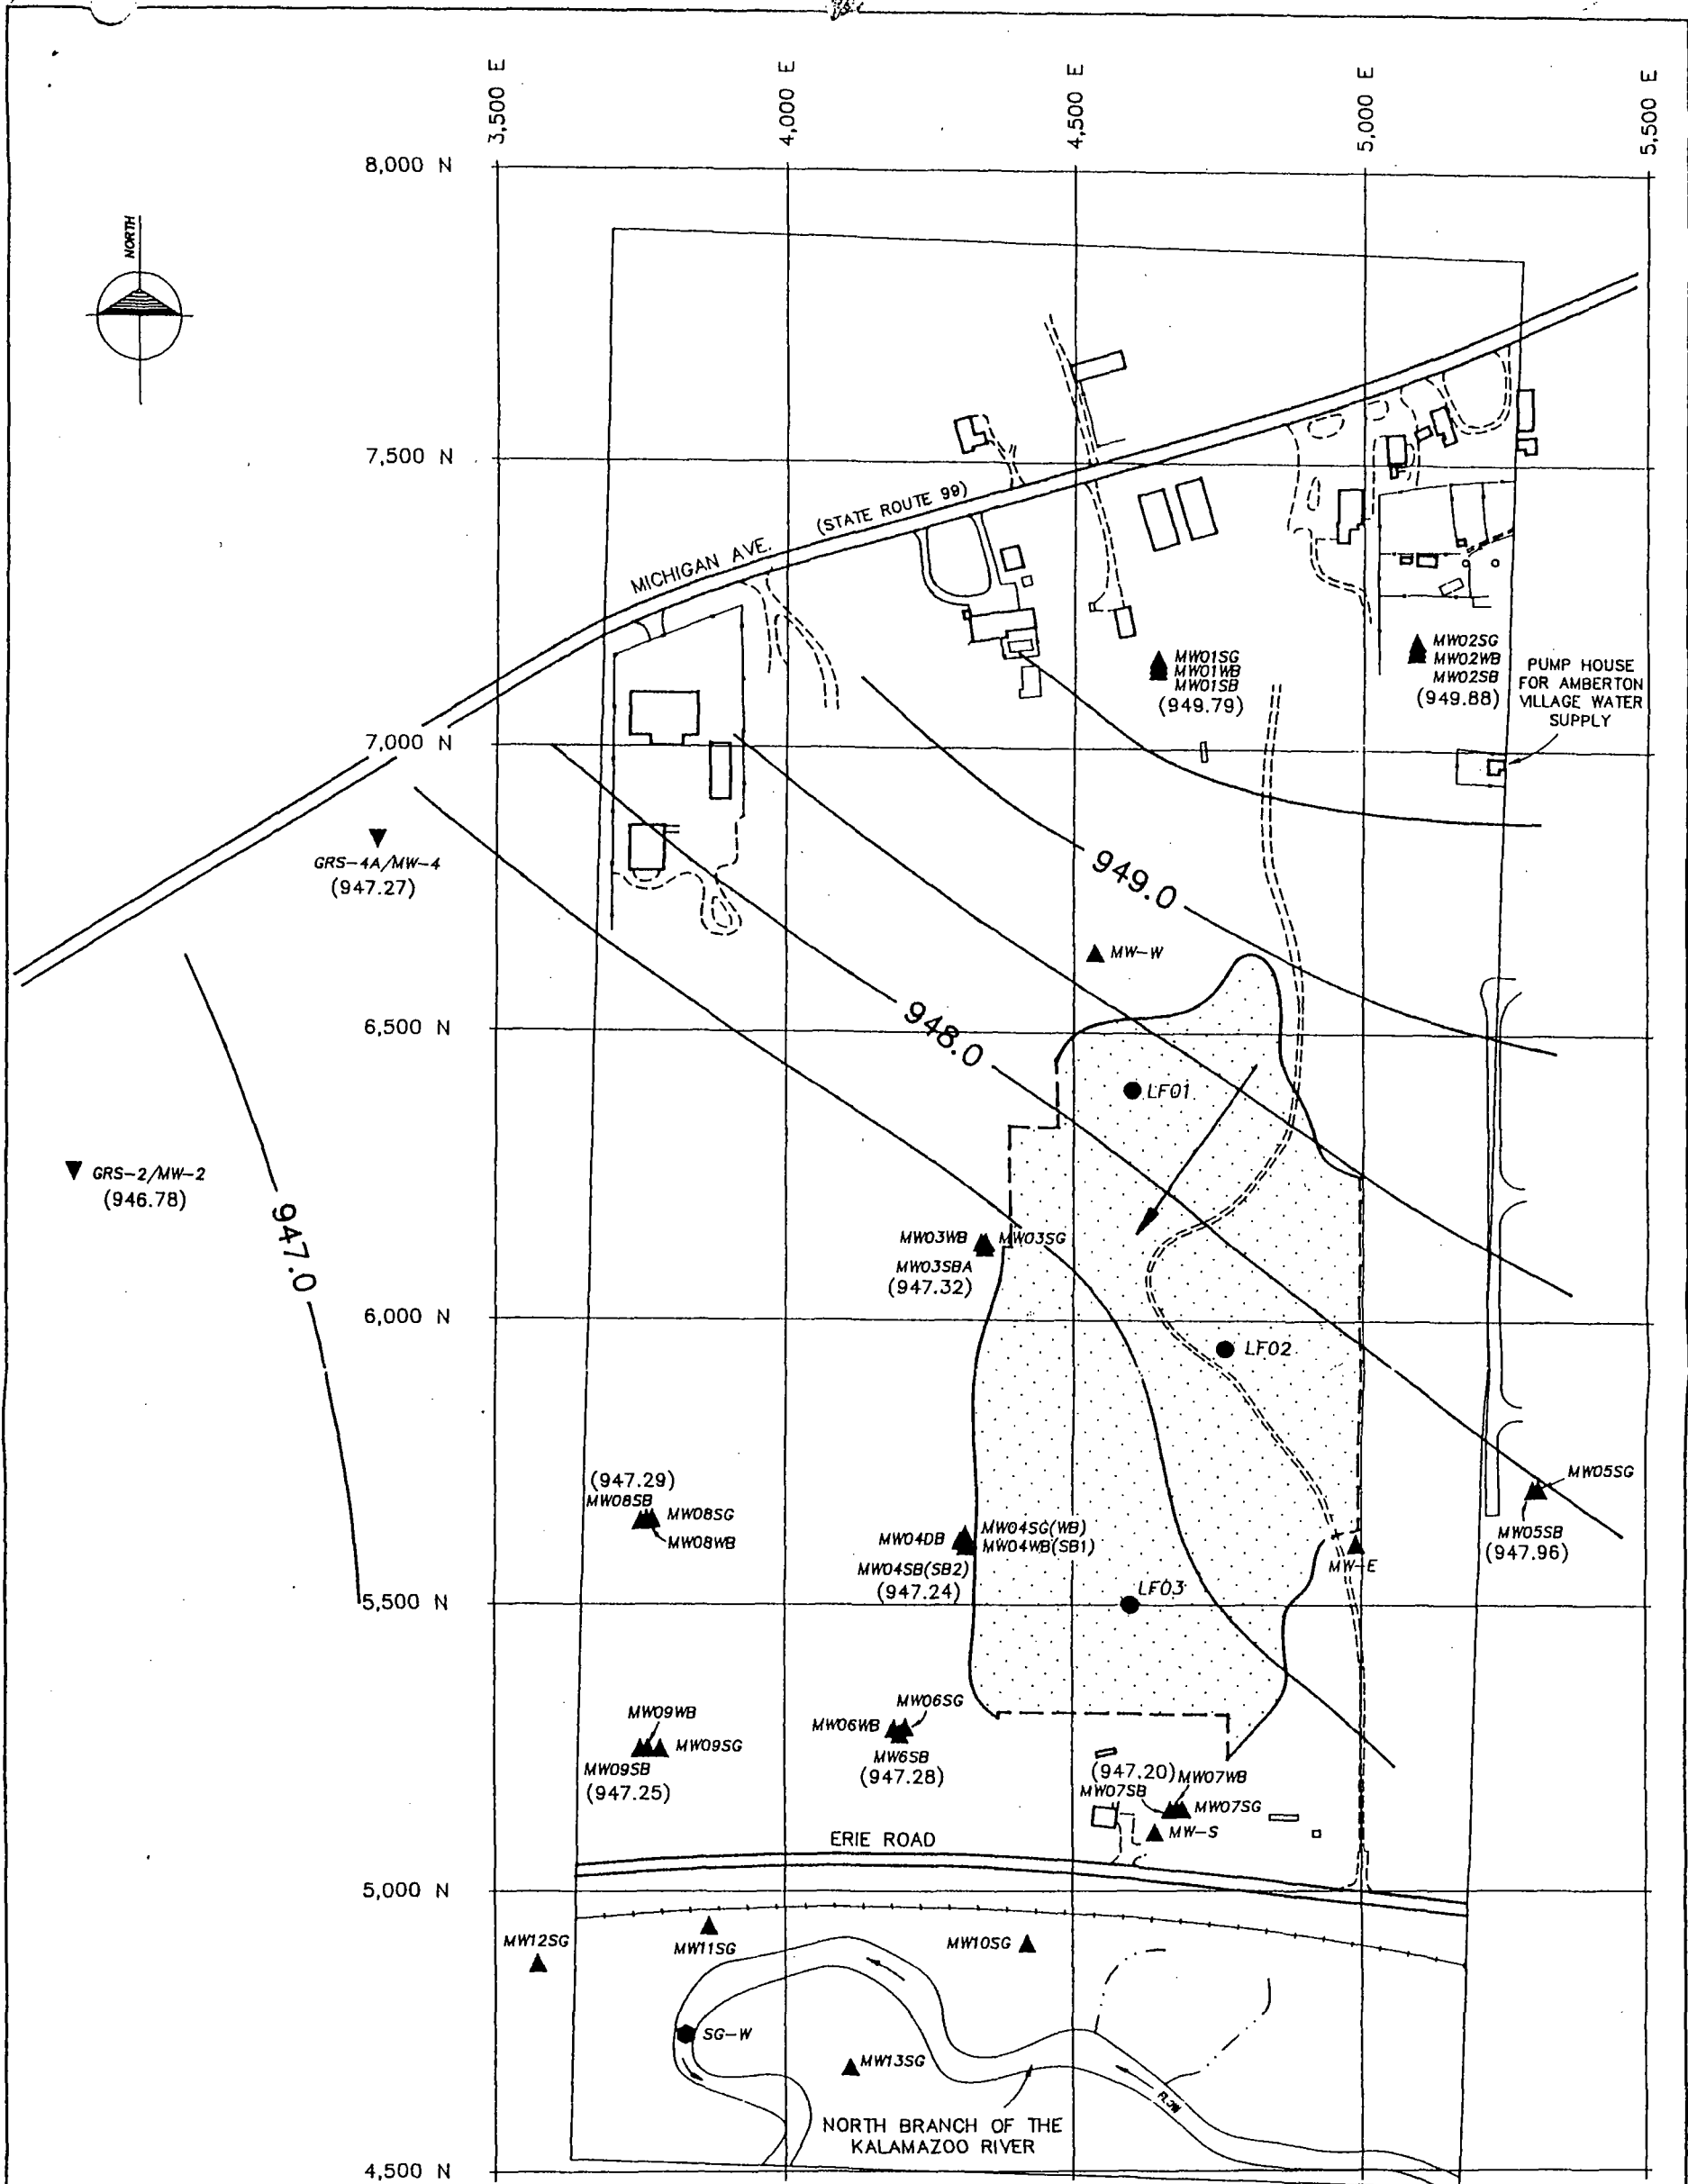

LEGEND

- APPROXIMATE LANDFILL BOUNDARY (DASHED PORTIONS INDICATE THE SURVEY GRID BOUNDARY)
- UNPAVED ROAD
- INTERMITTENT STREAM
- RAILROAD TRACK
- MONITORING WELL LOCATION
- LEACHATE WELL LOCATION
- GRS WELL LOCATION
- STAFF GAUGE LOCATION
- 948.0 — - GROUND WATER CONTOUR
- (947.27) — - GROUND WATER ELEVATION
- DIRECTION OF GROUND WATER FLOW

WATER LEVELS WERE MEASURED
IN SB-SERIES WELLS ON
MARCH 8, 1993.

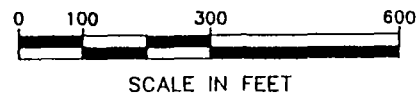

SCALE IN FEET

SBED-MAR
LVP042293

FIGURE 46
**SHALLOW BEDROCK
GROUND WATER FLOW MAP
(MARCH 8, 1993)**
ALBION-SHERIDAN TOWNSHIP LANDFILL
ALBION, MICHIGAN



APRIL, 1993

04011.03

SWL

Glacial


April '93

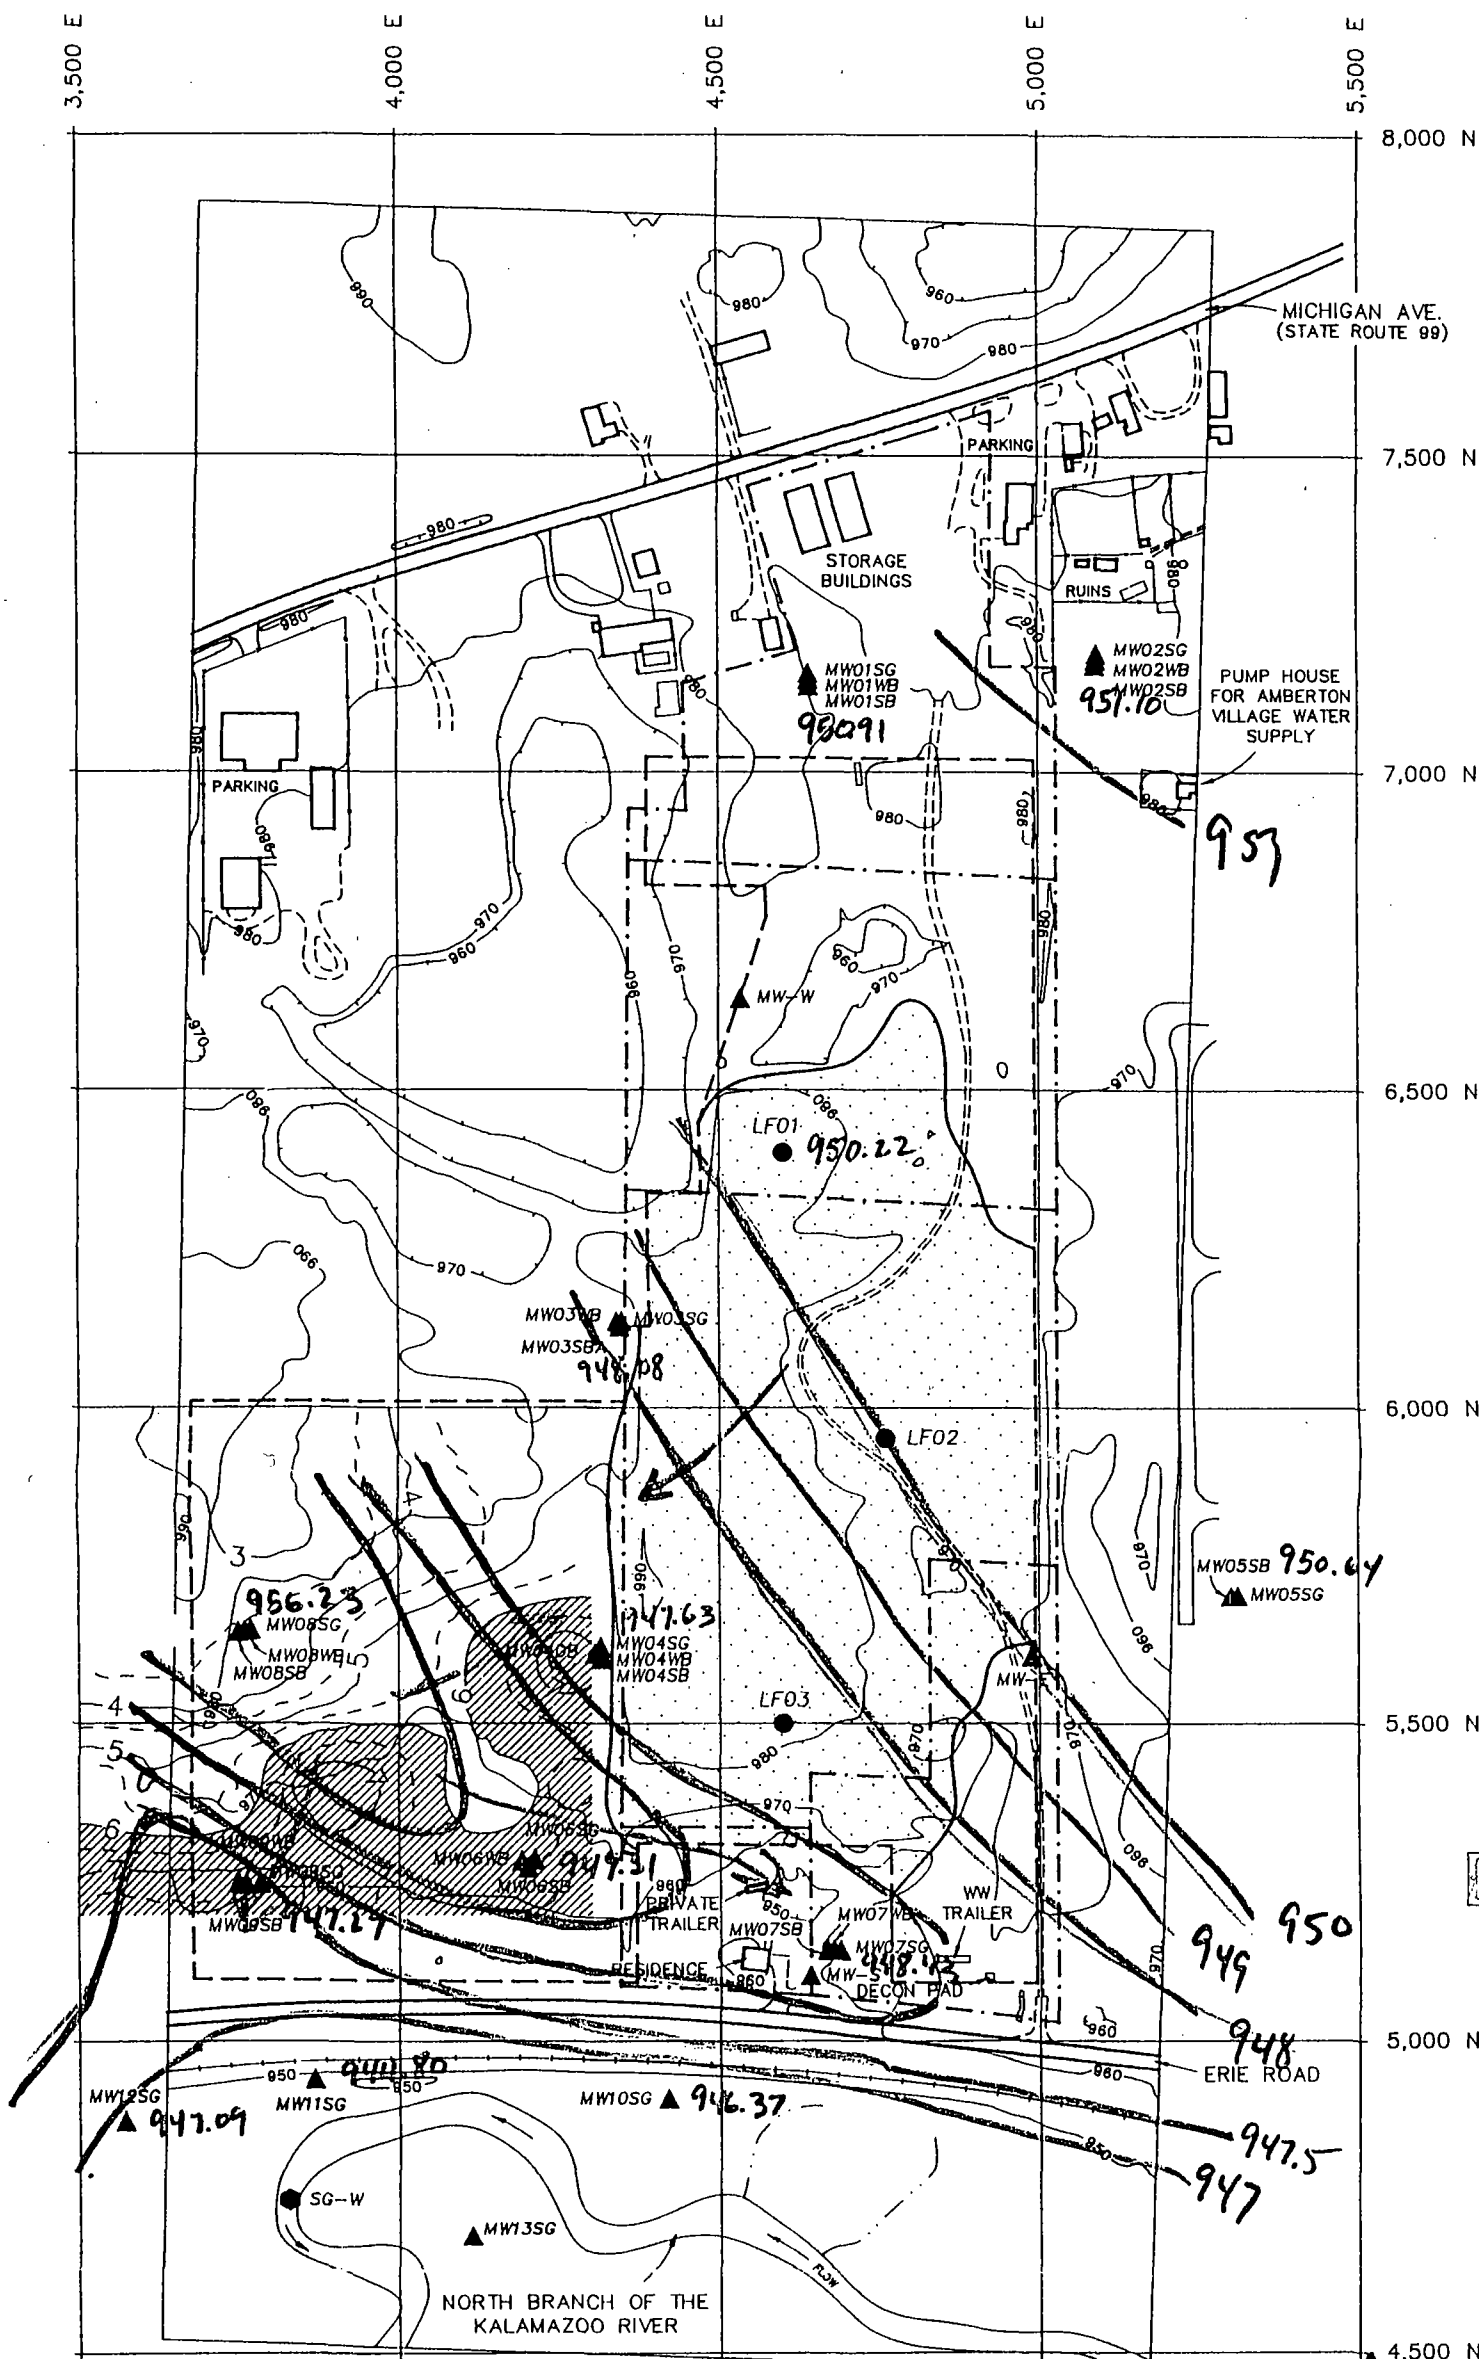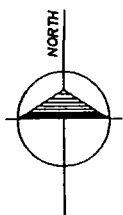

DRAFT

LEGEND

- APPROXIMATE LANDFILL BOUNDARY (DASHED PORTIONS INDICATE THE SURVEY GRID BOUNDARY)
- PROPERTY BOUNDARY
- TOPOGRAPHIC CONTOUR (10ft. interval)
- UNPAVED ROAD
- INTERMITTENT STREAM
- RAILROAD TRACK
- MONITORING WELL LOCATION
- LEACHATE WELL LOCATION
- STAFF GAUGE LOCATION
- LIMITS OF AREA SURVEYED WITH EM-34
- CONTOURED FM34 CONDUCTIVITY
- DEEP EM VALUES EXCEEDING 6 mmhos/m

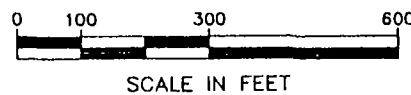

SCALE IN FEET

20M-H
LVP060493

FIGURE 14A
CONTOUR MAP OF
EM34 QUADRATURE PHASE
CONDUCTIVITY DATA
(20M HORIZONTAL)

ALBION-SHERIDAN TOWNSHIP LANDFILL
JUNE, 1993
ALBION, MICHIGAN



04011.03

Glacial
April 28, 1993

SWk

Weathered Bedrock

April

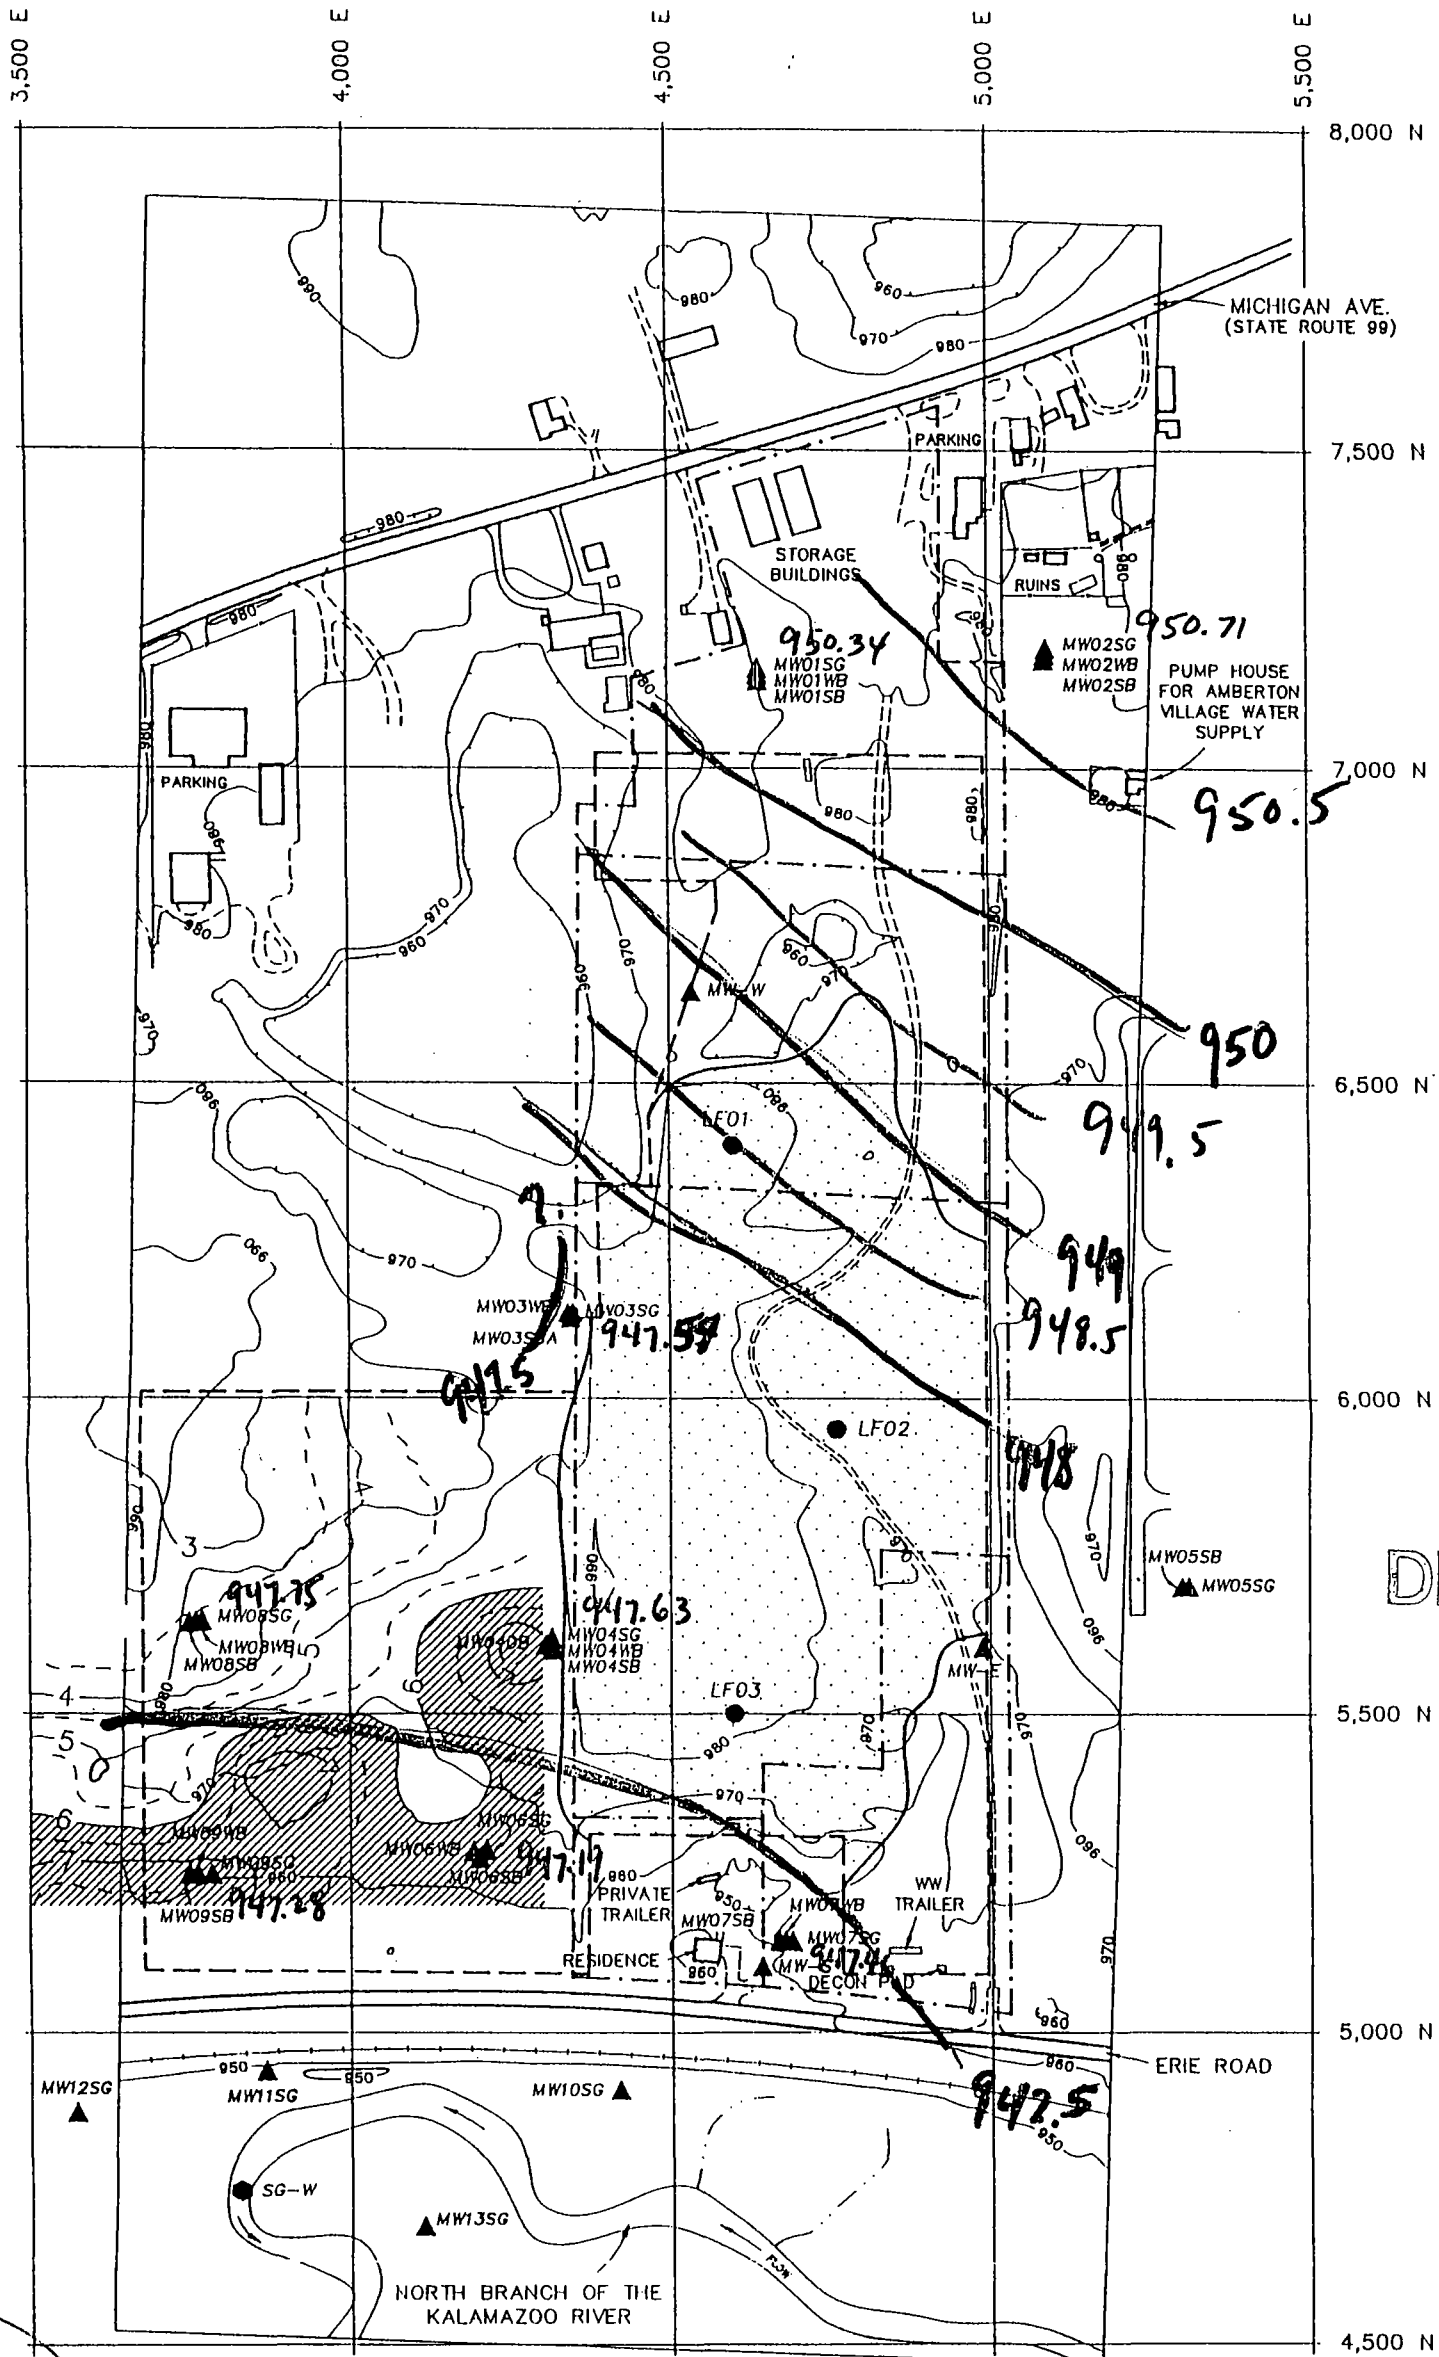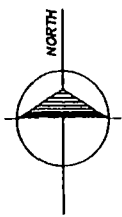

DRAFT

LEGEND

- APPROXIMATE LANDFILL BOUNDARY (DASHED PORTIONS INDICATE THE SURVEY GRID BOUNDARY)
- PROPERTY BOUNDARY
- TOPOGRAPHIC CONTOUR (10ft. Interval)
- UNPAVED ROAD
- INTERMITTENT STREAM
- RAILROAD TRACK
- MONITORING WELL LOCATION
- LEACHATE WELL LOCATION
- STAFF GAUGE LOCATION
- LIMITS OF AREA SURVEYED WITH EM-34
- CONTOURED FM34 CONDUCTIVITY
- DEEP EM VALUES EXCEEDING 6 mrmhos/m

0 100 300 600
SCALE IN FEET

FIGURE 14A
CONTOUR MAP OF
EM34 QUADRATURE PHASE
CONDUCTIVITY DATA
(20M HORIZONTAL)



ALBION-SHERIDAN TOWNSHIP LANDFILL
JUNE, 1993 ALBION, MICHIGAN 04011.03

20M-H
LVP060493

SWL


Shallow Bedrock

April

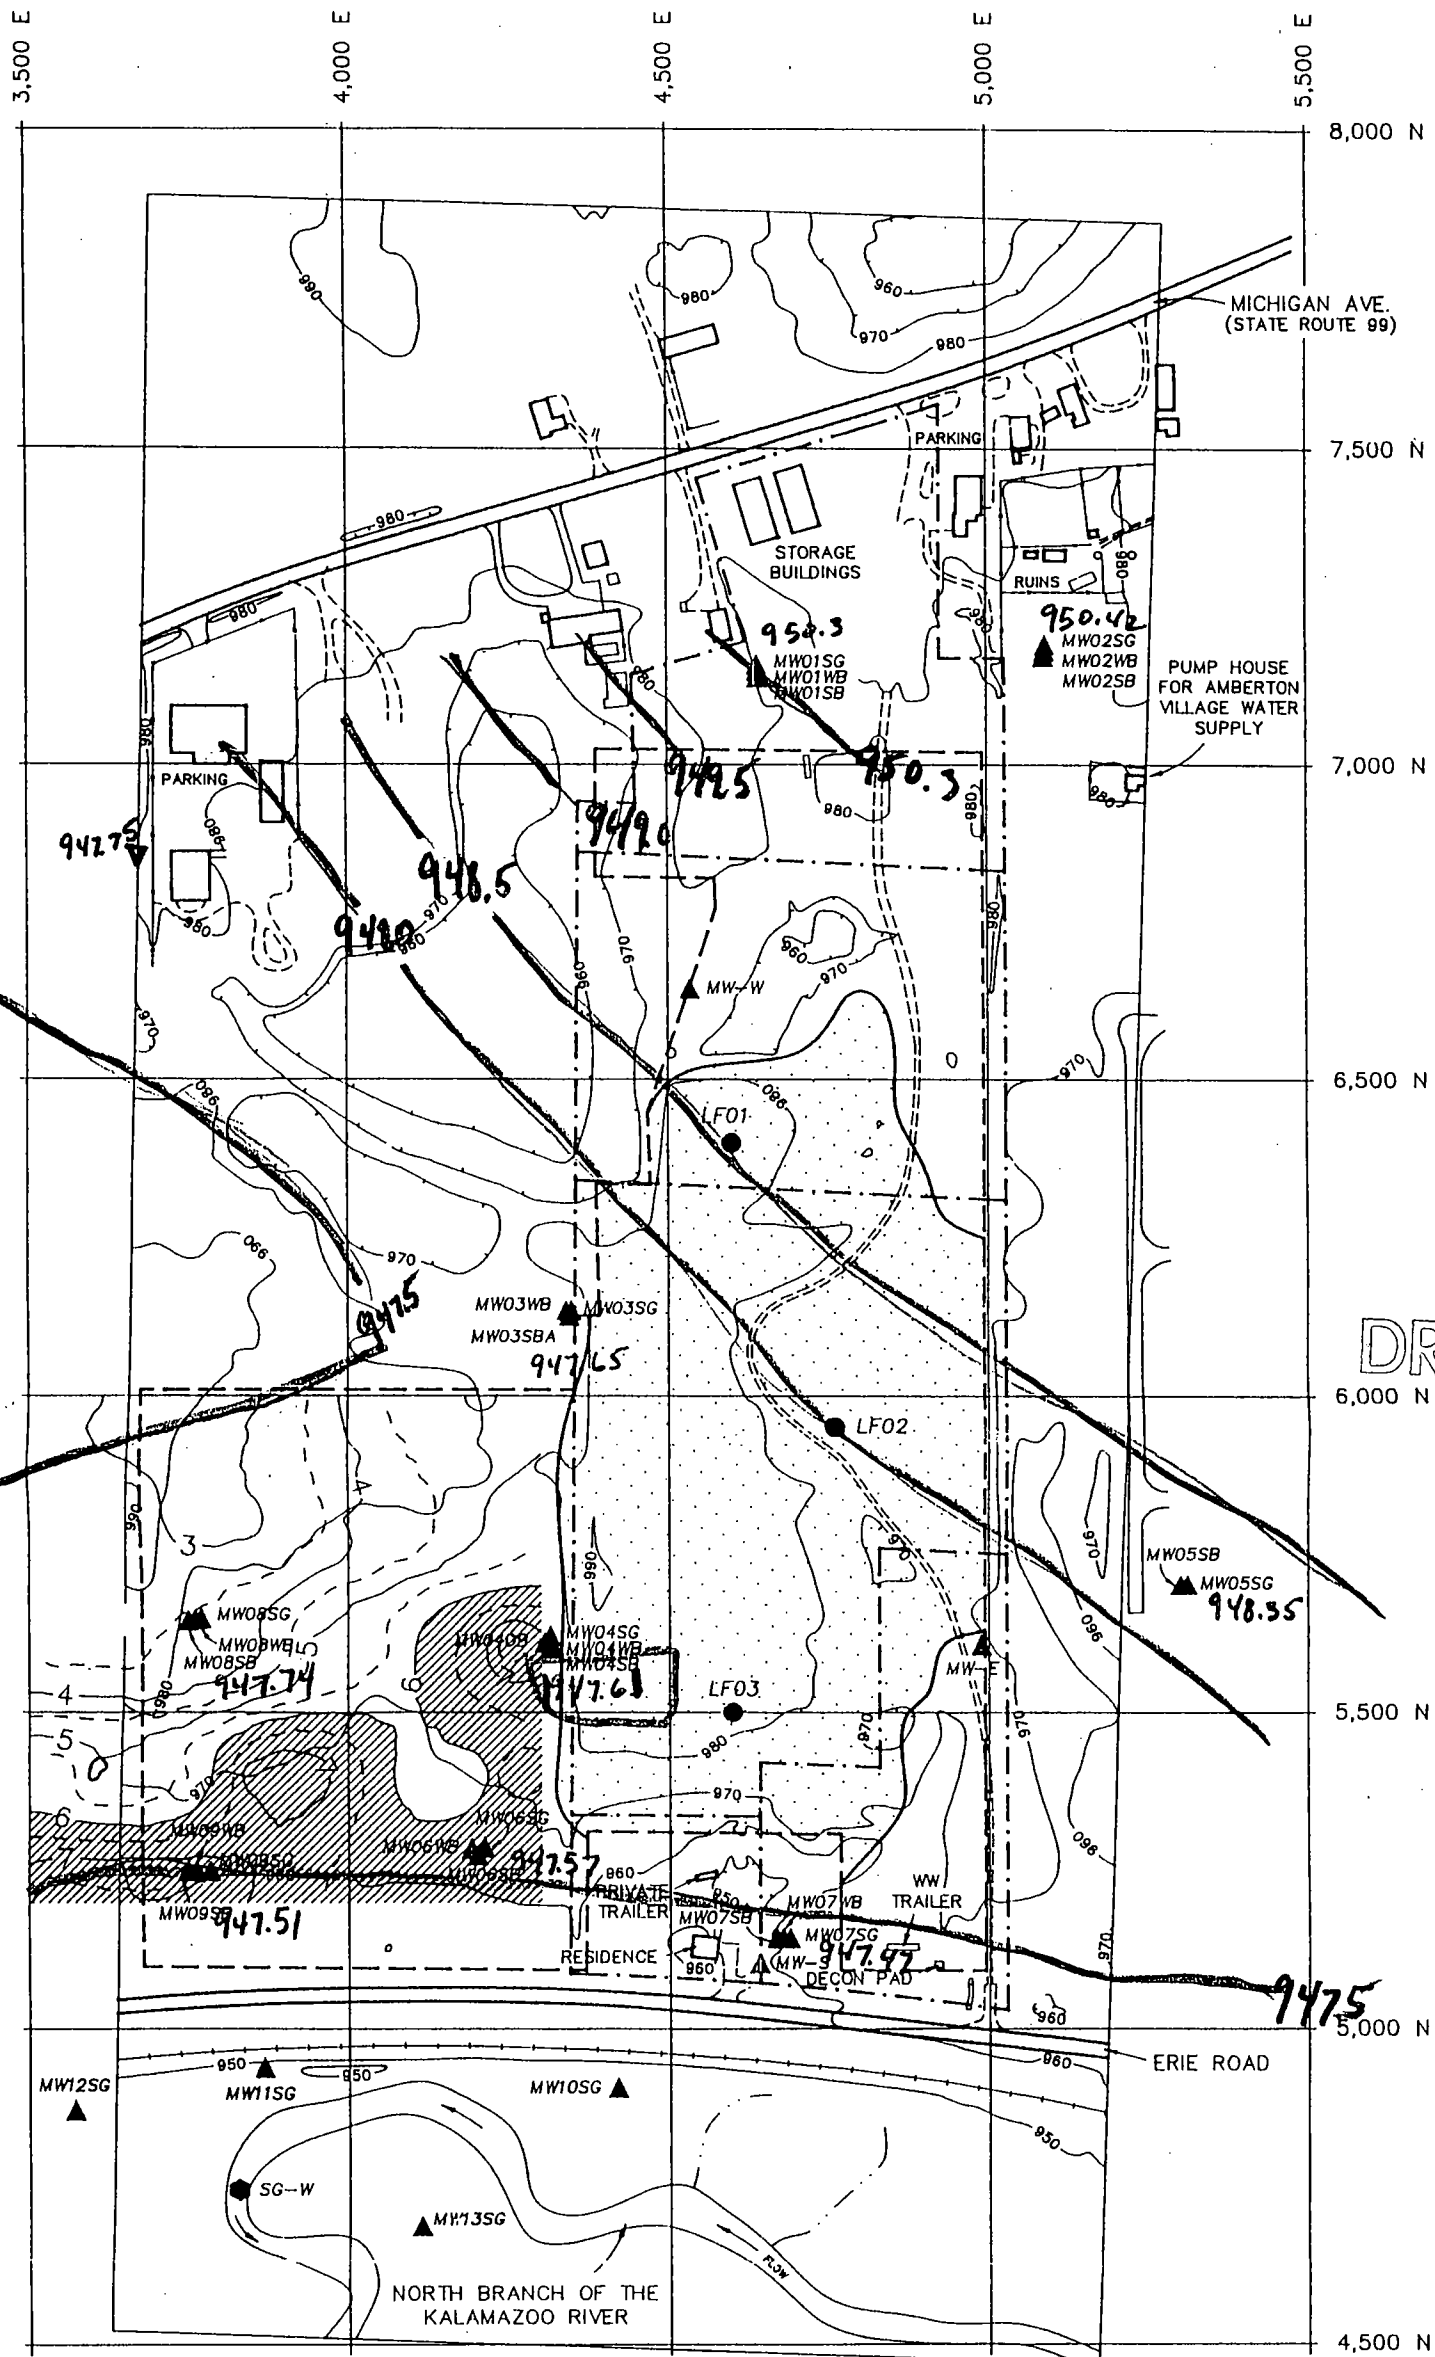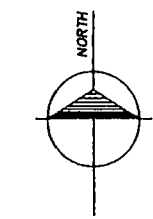

LEGEND

- APPROXIMATE LANDFILL BOUNDARY (DASHED PORTIONS INDICATE THE SURVEY GRID BOUNDARY)
- PROPERTY BOUNDARY
- TOPOGRAPHIC CONTOUR (10ft. Interval)
- UNPAVED ROAD
- INTERMITTENT STREAM
- RAILROAD TRACK
- MONITORING WELL LOCATION
- LEACHATE WELL LOCATION
- STAFF GAUGE LOCATION
- LIMITS OF AREA SURVEYED WITH EM-34
- CONTOURED FM34 CONDUCTIVITY
- DEEP EM VALUES EXCEEDING 6 mmhos/m

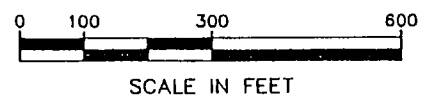

SCALE IN FEET

20M-H
LVP060493



FIGURE 14A CONTOUR MAP OF EM34 QUADRATURE PHASE CONDUCTIVITY DATA (20M HORIZONTAL)

ALBION-SHERIDAN TOWNSHIP LANDFILL
JUNE, 1993 ALBION, MICHIGAN 04011.03

SWL

Glacial

August 93

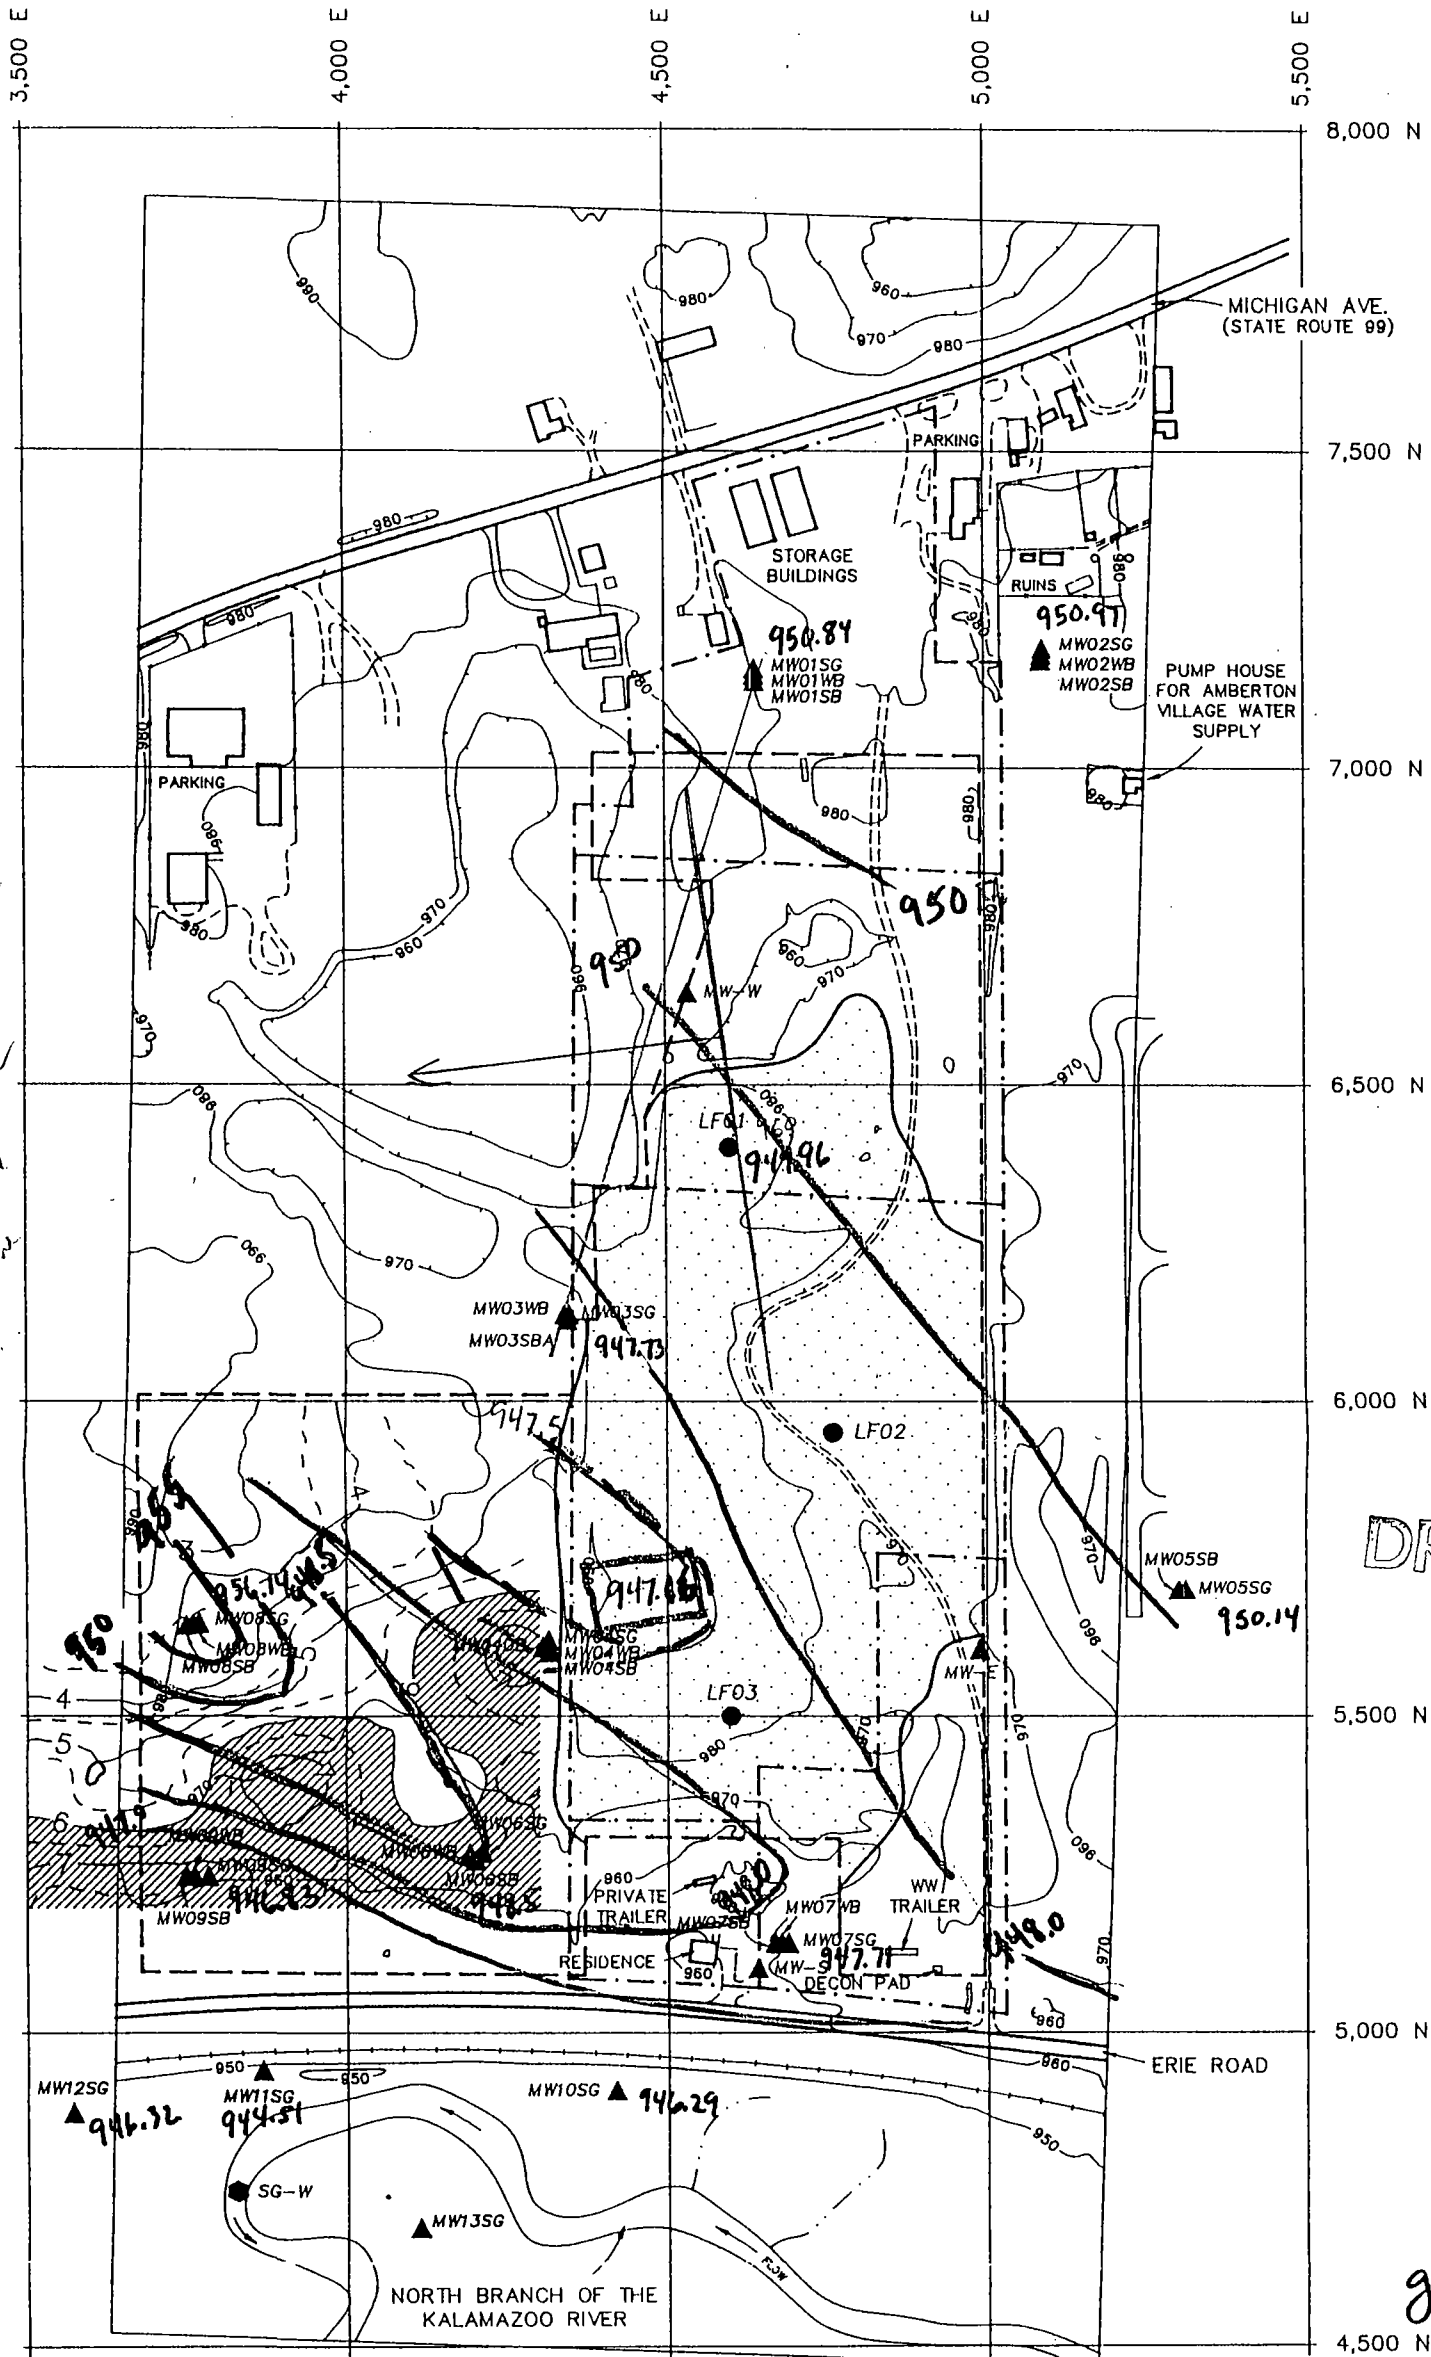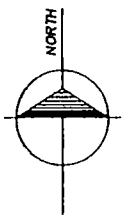


DRAFT

LEGEND

- APPROXIMATE LANDFILL BOUNDARY (DASHED PORTIONS INDICATE THE SURVEY GRID BOUNDARY)
- PROPERTY BOUNDARY
- 970 — TOPOGRAPHIC CONTOUR (10ft. interval)
- UNPAVED ROAD
- INTERMITTENT STREAM
- RAILROAD TRACK
- ▲ MONITORING WELL LOCATION
- LEACHATE WELL LOCATION
- STAFF GAUGE LOCATION
- LIMITS OF AREA SURVEYED WITH EM-34
- CONTOURED FM34 CONDUCTIVITY
- DEEP EM VALUES EXCEEDING 6 mmhos/m

August 10, 1993

only month where MW7 was lower than MW3.
usual it is app. .3 to .4 foot lower.

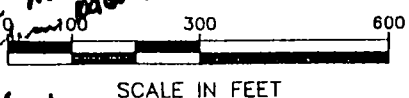

SCALE IN FEET

20M-H
LVP060493

FIGURE 14A
CONTOUR MAP OF
EM34 QUADRATURE PHASE
CONDUCTIVITY DATA
(20M HORIZONTAL)

ALBION-SHERIDAN TOWNSHIP LANDFILL
JUNE, 1993
ALBION, MICHIGAN
04011.03

Aug '93



FIGURE 46
~~SHALLOW BEDROCK~~
GROUND WATER FLOW MAP
(MARCH 8, 1993)
ALBION-SHERIDAN TOWNSHIP LANDFILL
ALBION, MICHIGAN
APRIL, 1993 04011.03

Aug 93



Shallow Bed Rock.
August 10, 1993

-
- 0 100 300 600
- SCALE IN FEET


20M-H
LVP060493

FIGURE 14A
CONTOUR MAP OF
EM34 QUADRATURE PHASE
CONDUCTIVITY DATA
(20M HORIZONTAL)

ALBION-SHERIDAN TOWNSHIP LANDFILL
JUNE, 1993 ALBION, MICHIGAN 04

04011.03



Sept 93

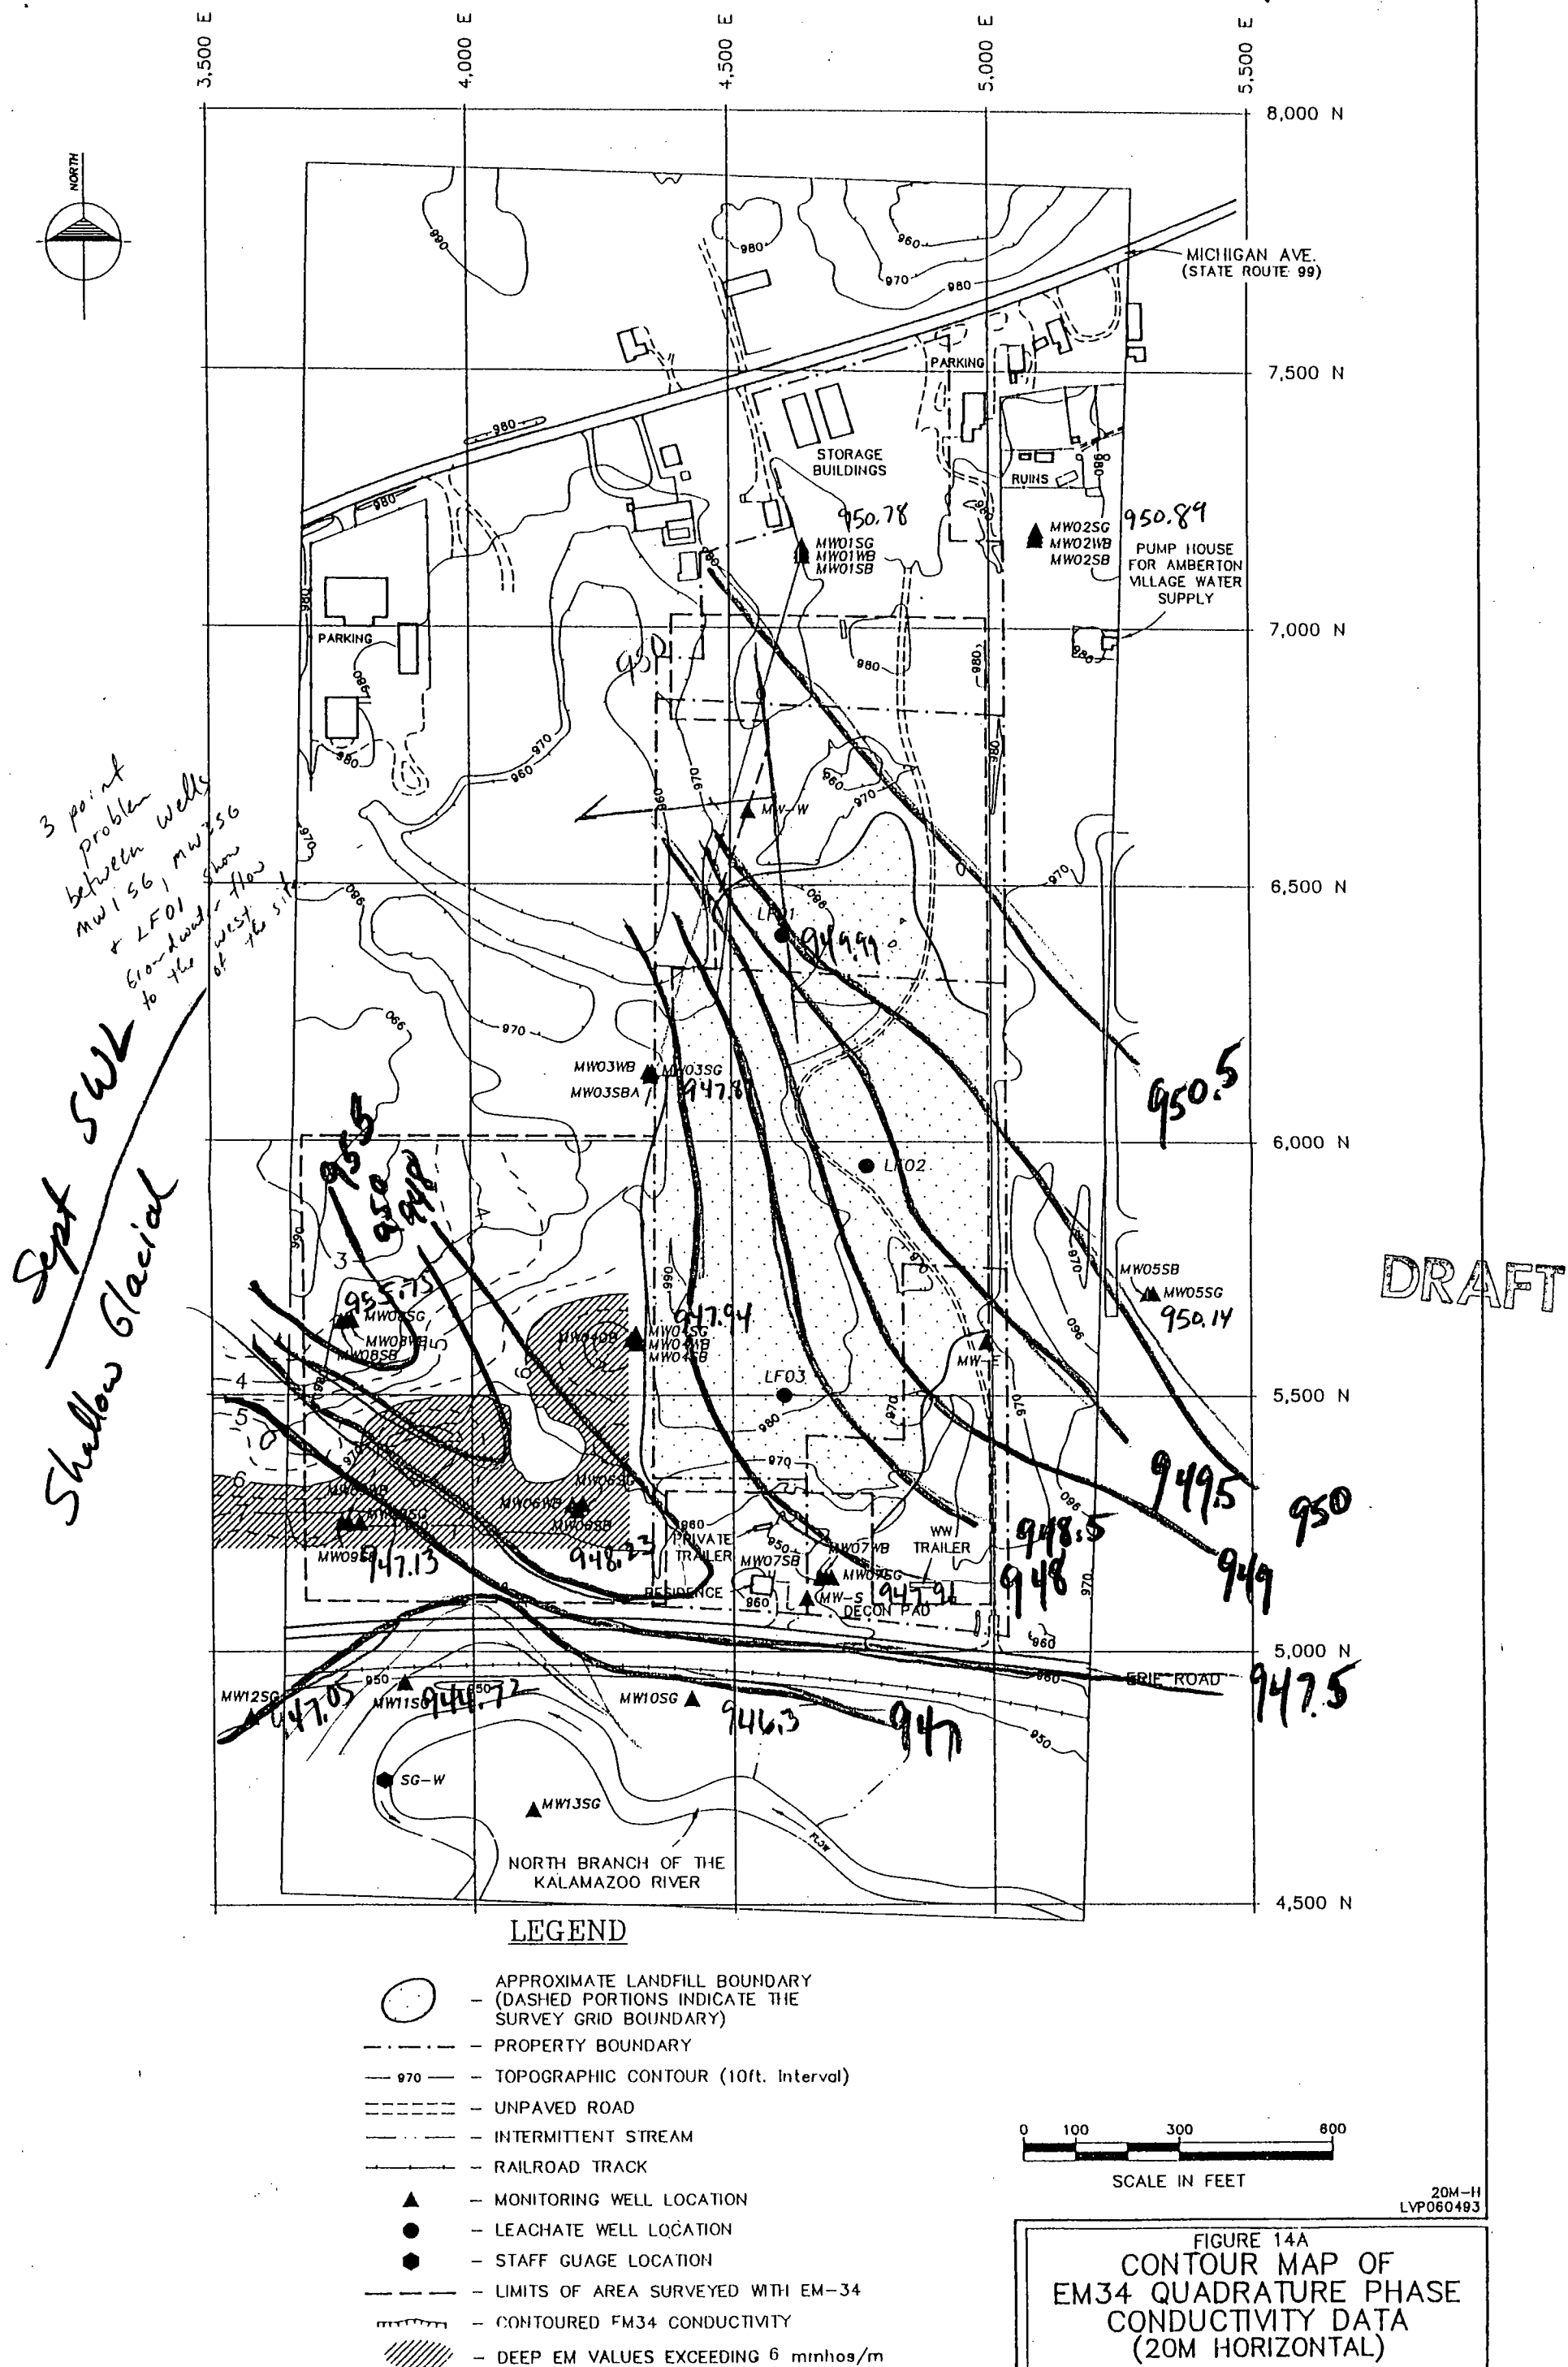

SWL

Weathered Bed Rock


Sept '93

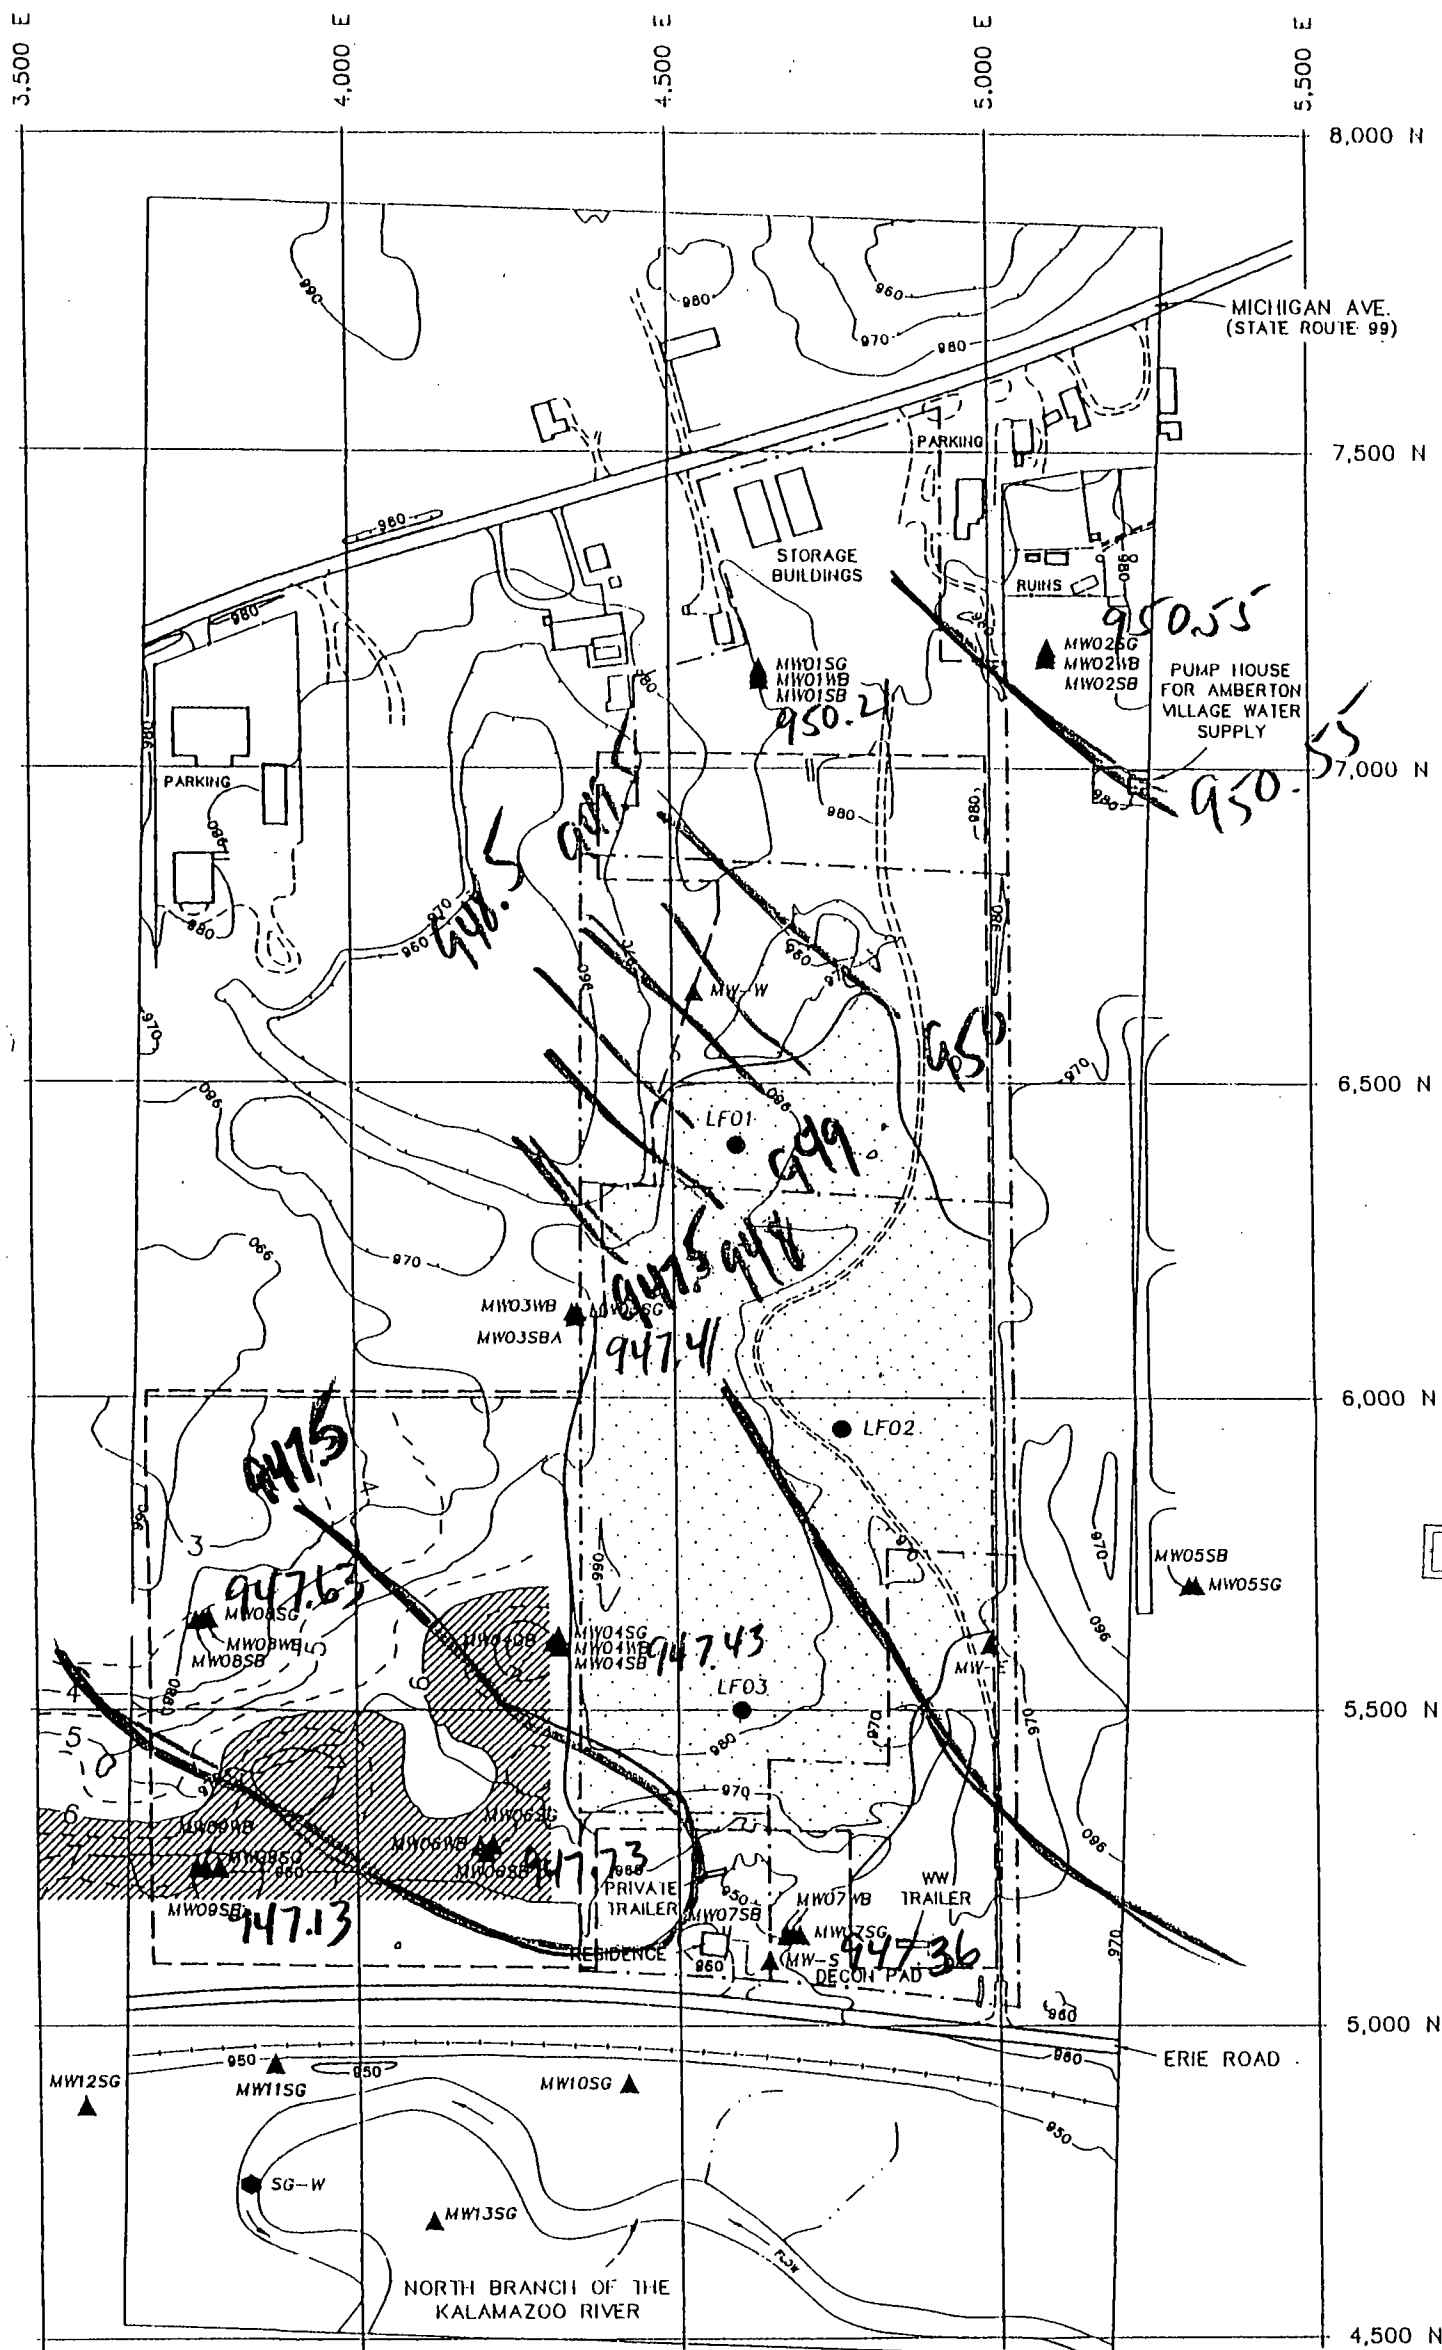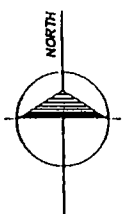

DRAFT

LEGEND

- APPROXIMATE LANDFILL BOUNDARY (DASHED PORTIONS INDICATE THE SURVEY GRID BOUNDARY)
- PROPERTY BOUNDARY
- TOPOGRAPHIC CONTOUR (10ft. Interval)
- UNPAVED ROAD
- INTERMITTENT STREAM
- RAILROAD TRACK
- MONITORING WELL LOCATION
- LEACHATE WELL LOCATION
- STAFF GAUGE LOCATION
- LIMITS OF AREA SURVEYED WITH EM-34
- CONTOURED EM34 CONDUCTIVITY
- DEEP EM VALUES EXCEEDING 6 mhos/m

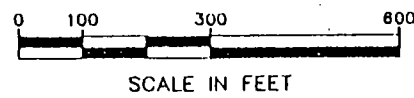

SCALE IN FEET

20M-H
LVP060493

FIGURE 14A
CONTOUR MAP OF
EM34 QUADRATURE PHASE
CONDUCTIVITY DATA
(20M HORIZONTAL)


ALBION-SHERIDAN TOWNSHIP LANDFILL
JULIE, 1993 ALBION, MICHIGAN 04011.03

SWL

Shallow Bedrock

Sept '93

Shallow Bedrock

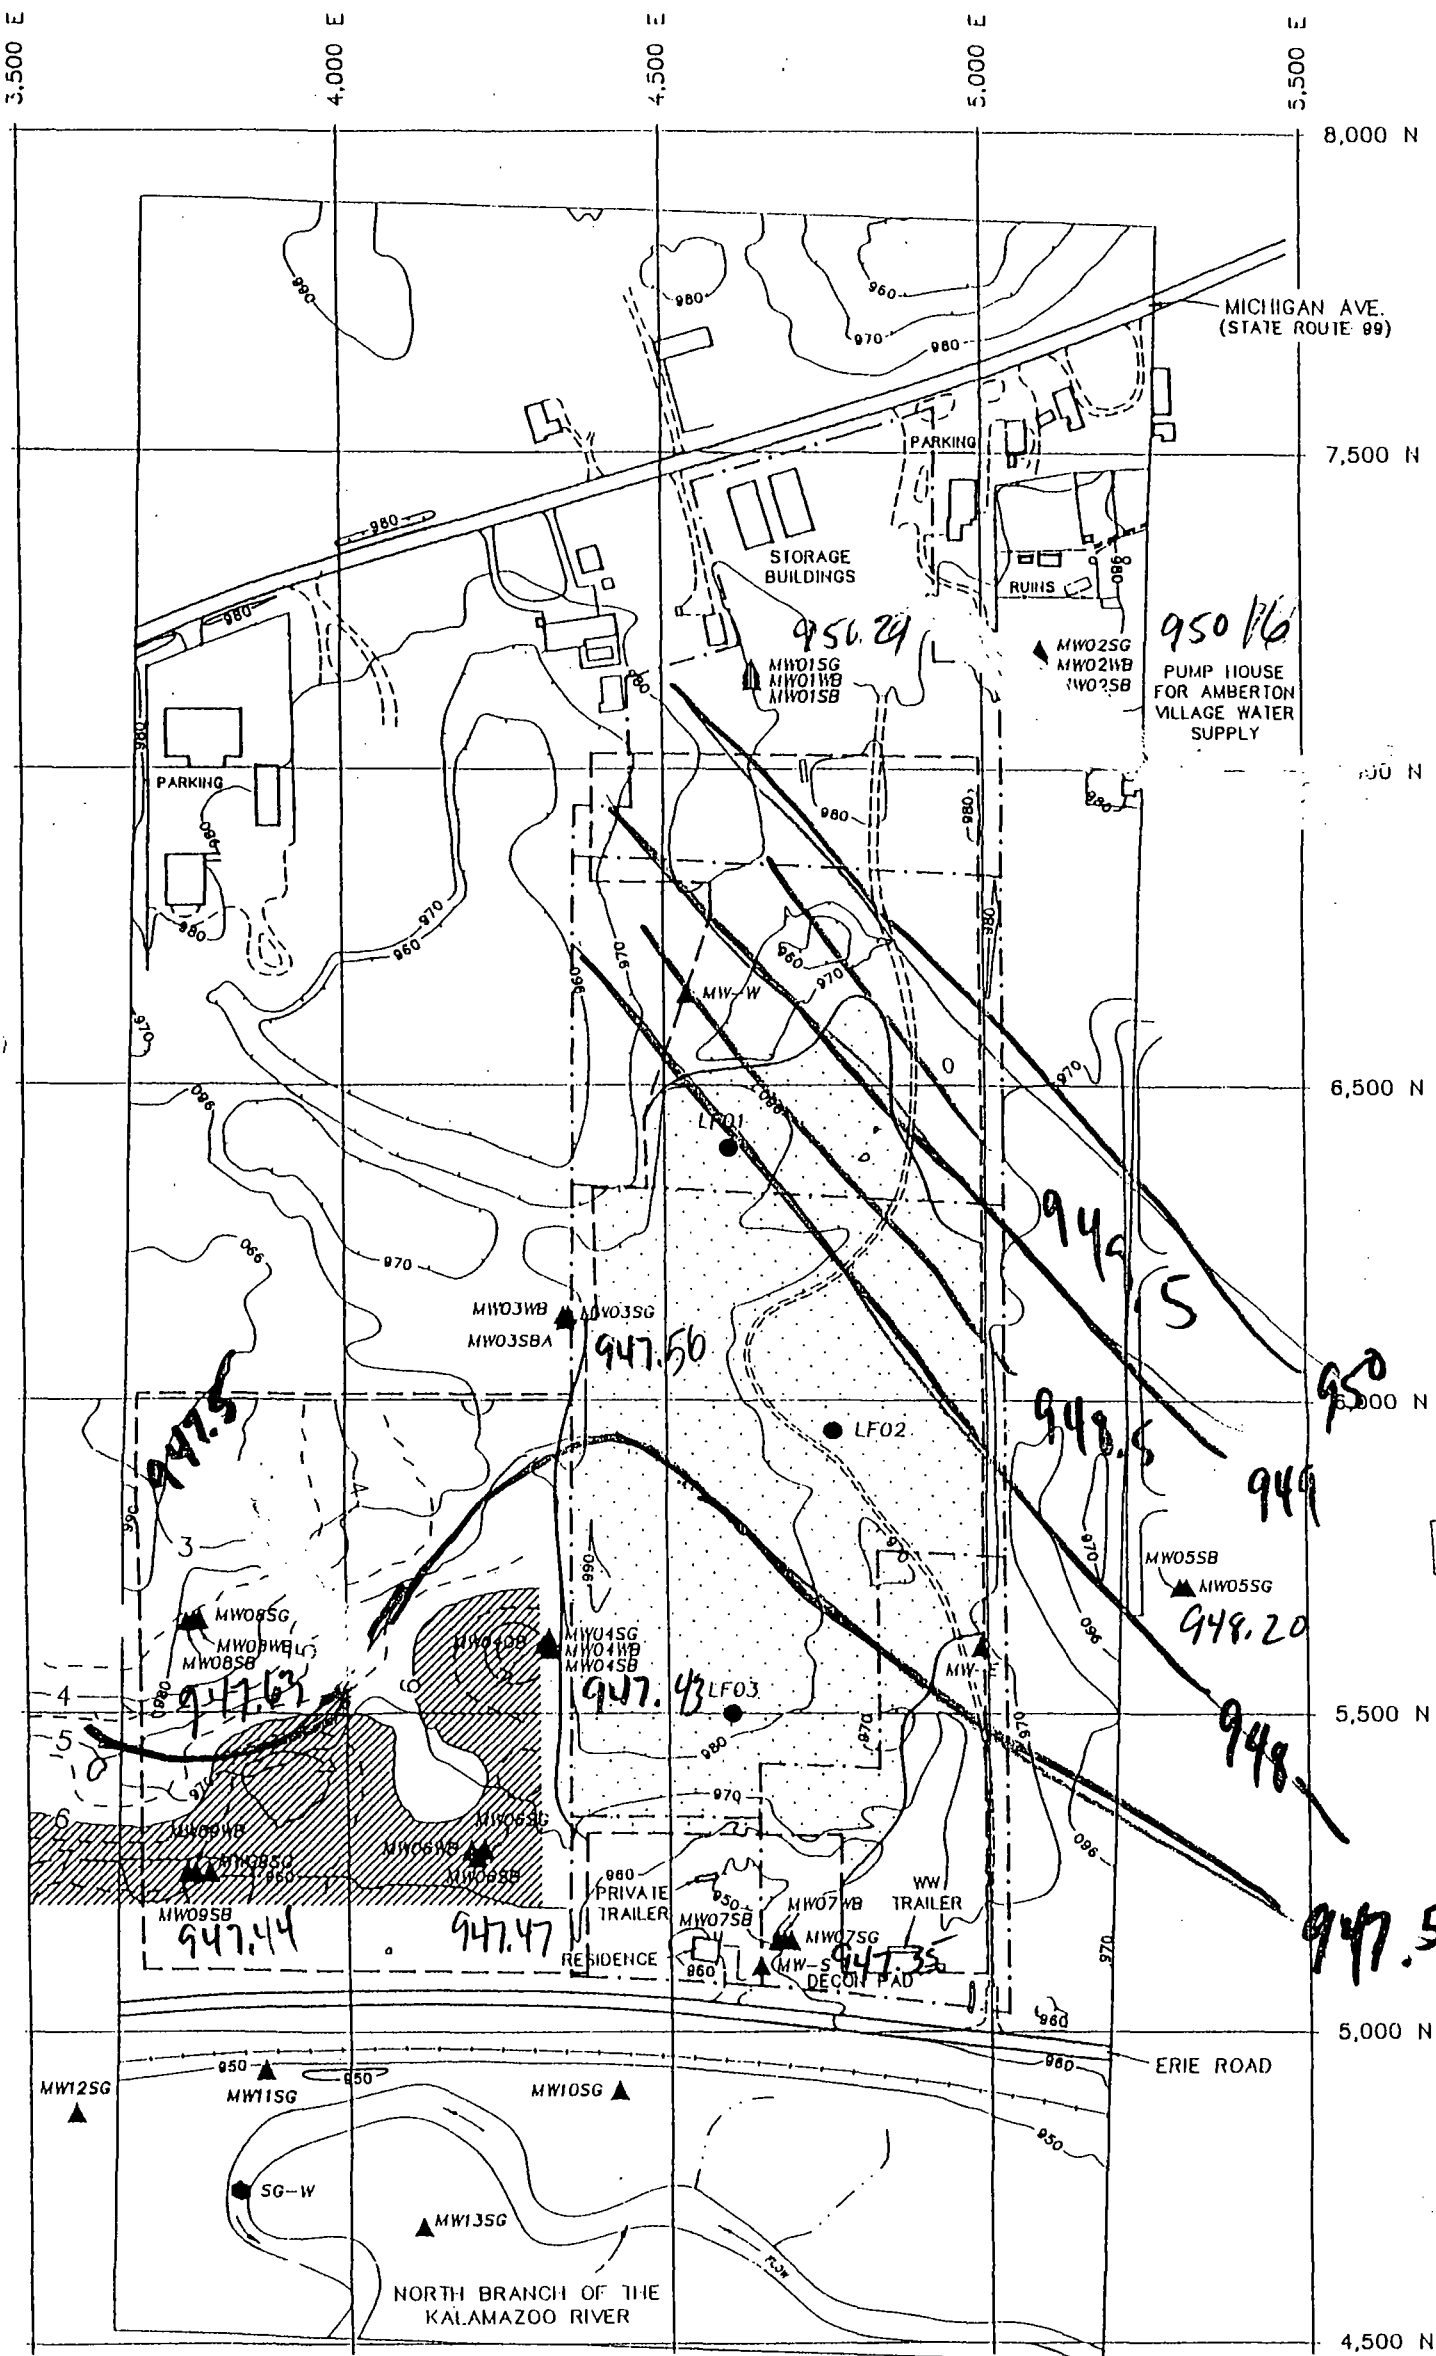

DRAFT

LEGEND

- APPROXIMATE LANDFILL BOUNDARY (DASHED PORTIONS INDICATE THE SURVEY GRID BOUNDARY)
- PROPERTY BOUNDARY
- TOPOGRAPHIC CONTOUR (10ft. Interval)
- UNPAVED ROAD
- INTERMITTENT STREAM
- RAILROAD TRACK
- MONITORING WELL LOCATION
- LEACHATE WELL LOCATION
- STAFF GAUGE LOCATION
- LIMITS OF AREA SURVEYED WITH EM-34
- CONTOURED FM34 CONDUCTIVITY
- DEEP EM VALUES EXCEEDING 6 minhos/m

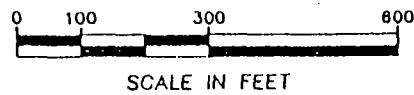


FIGURE 14A
CONTOUR MAP OF
EM34 QUADRATURE PHASE
CONDUCTIVITY DATA
(20M HORIZONTAL)

ALBION-SHERIDAN TOWNSHIP LANDFILL
JUNE, 1993 ALBION, MICHIGAN 01011.03

20M-H
LVP060483

Nov. '93





-
- A horizontal scale bar with tick marks at 0, 100, 300, and 600 feet. The text "SCALE IN FEET" is centered below the bar.

ALBION--SHERIDAN TOWNSHIP LANDFILL
JUNE, 1993 ALBION, MICHIGAN 04011.03

SWL

Weathered Bed Rock


Nov 1993

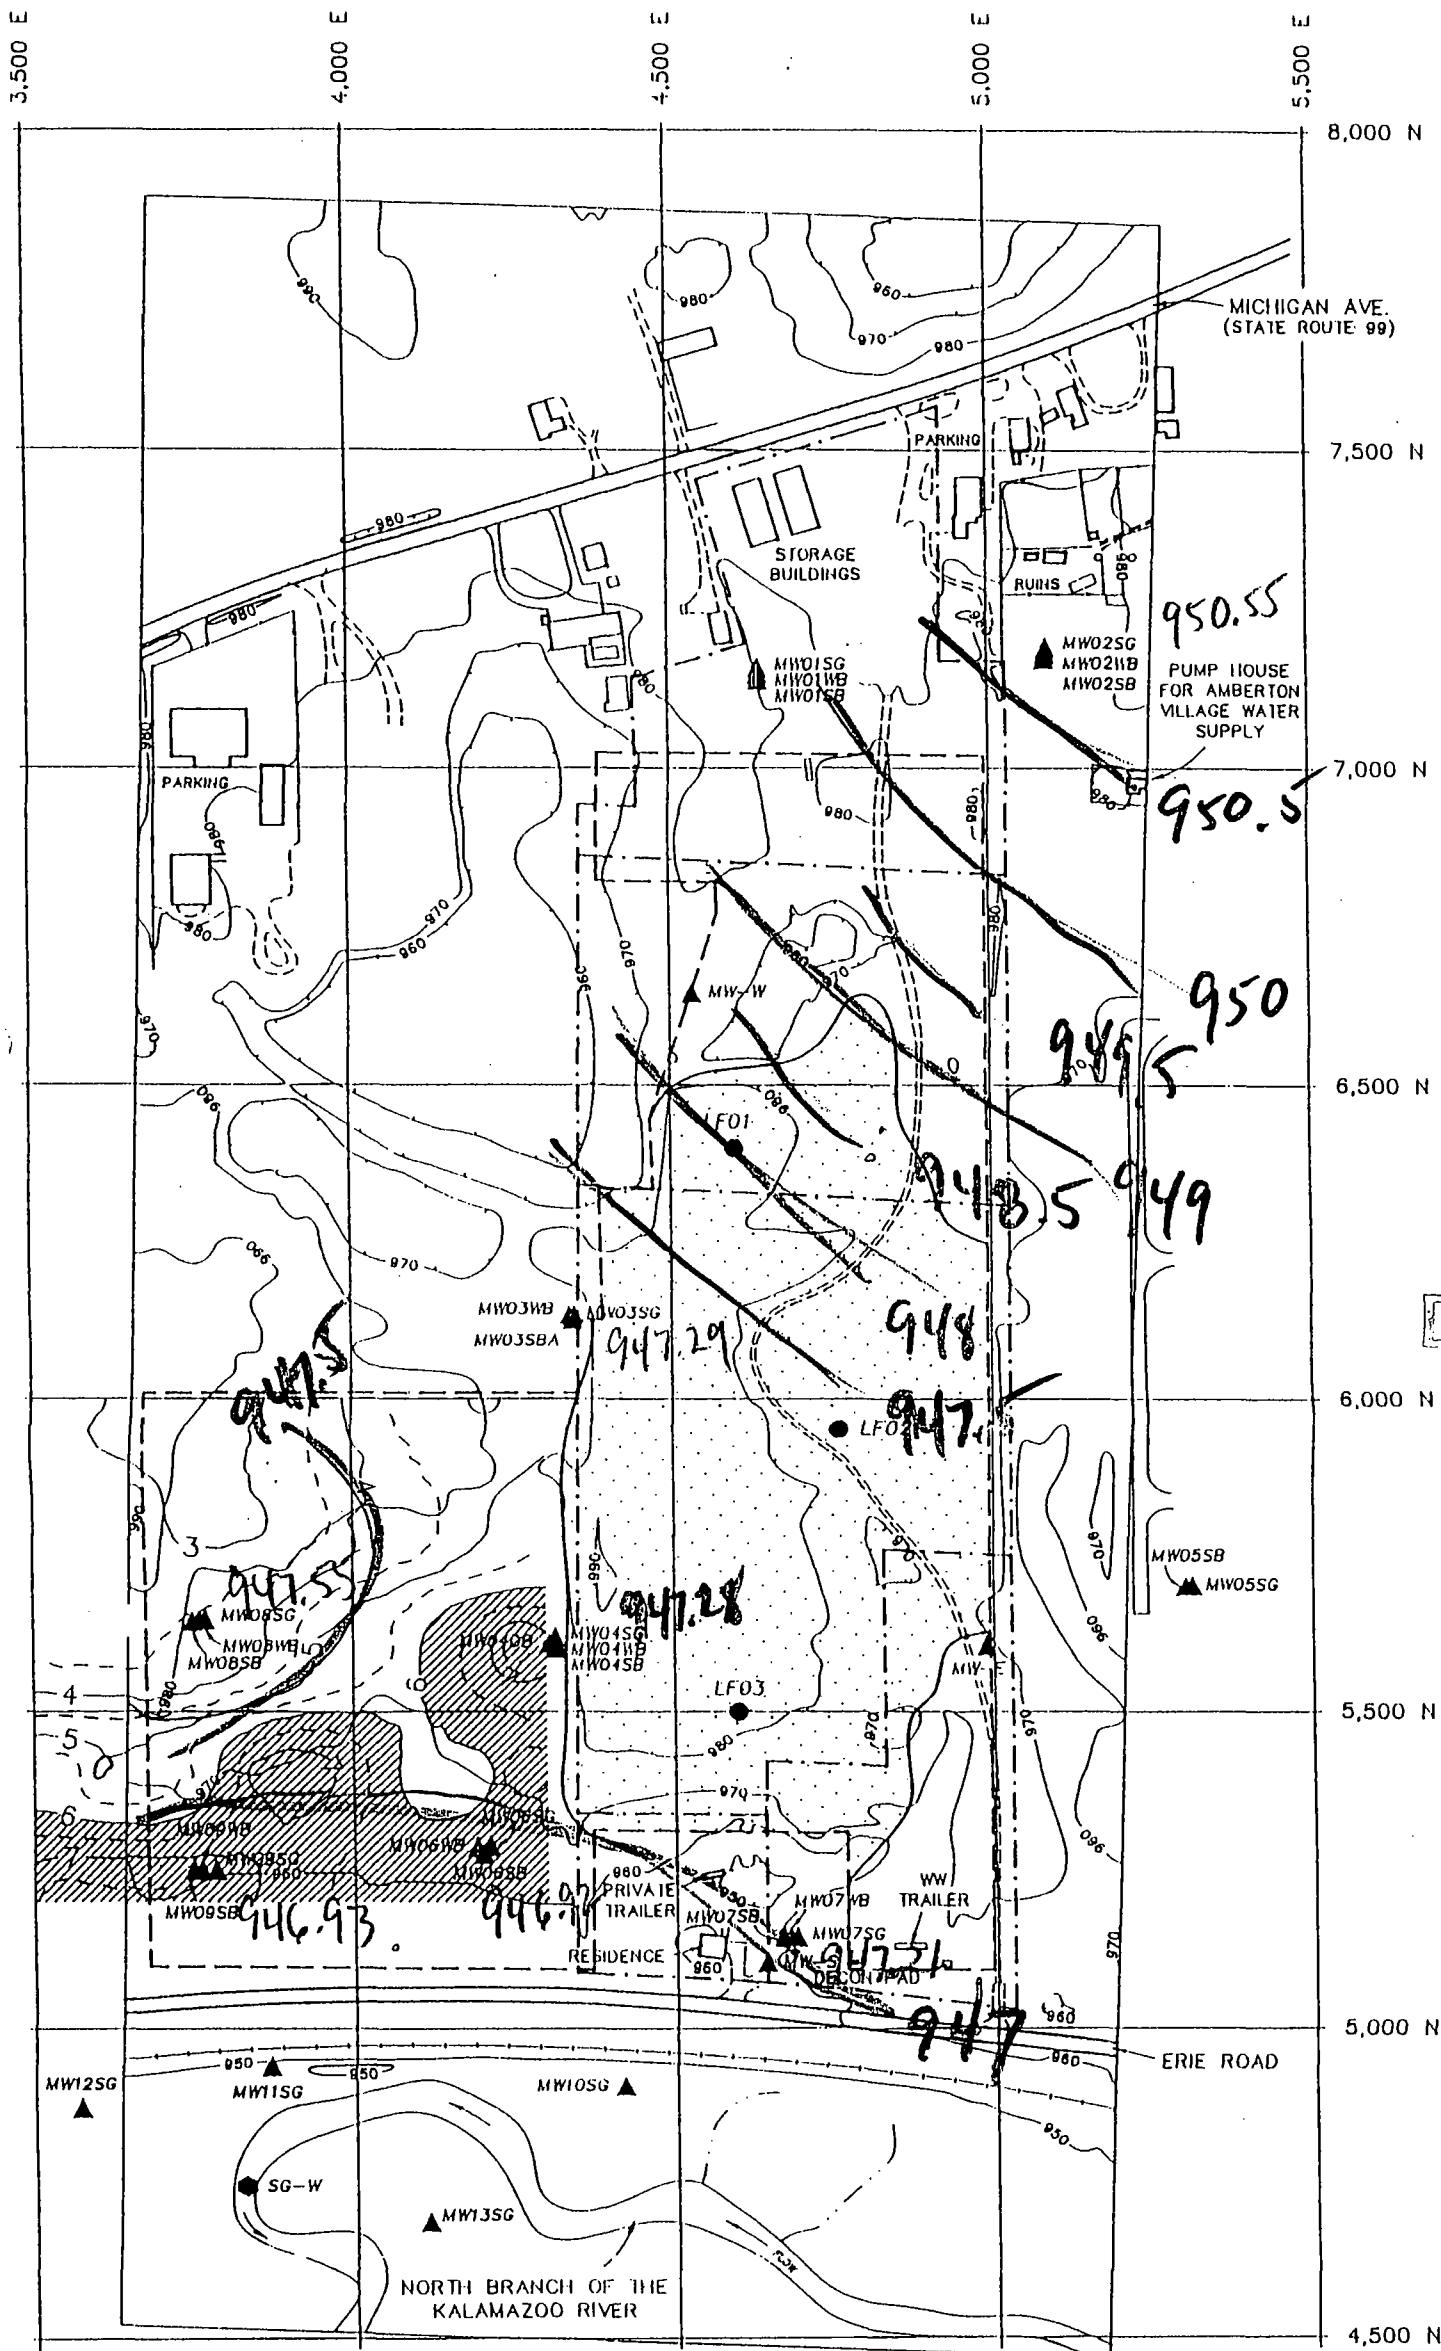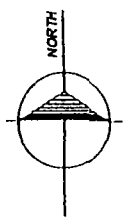

DRAFT

LEGEND

- APPROXIMATE LANDFILL BOUNDARY (DASHED PORTIONS INDICATE THE SURVEY GRID BOUNDARY)
- PROPERTY BOUNDARY
- TOPOGRAPHIC CONTOUR (10ft. Interval)
- UNPAVED ROAD
- INTERMITTENT STREAM
- RAILROAD TRACK
- MONITORING WELL LOCATION
- LEACHATE WELL LOCATION
- STAFF GAUGE LOCATION
- LIMITS OF AREA SURVEYED WITH EM-34
- CONTOURED EM34 CONDUCTIVITY
- DEEP EM VALUES EXCEEDING 6 mmhos/m

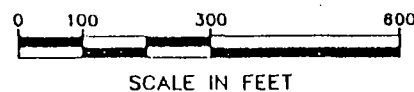

SCALE IN FEET

20M-11
LVP080493

FIGURE 14A
CONTOUR MAP OF
EM34 QUADRATURE PHASE
CONDUCTIVITY DATA
(20M HORIZONTAL)

ALBION-SHERIDAN TOWNSHIP LANDFILL
JULIE, 1993 ALBION, MICHIGAN 04011.03

WW Engineering & Science